

Registration Statement

OF CLAIMANT OF RIGHT TO APPROPRIATE GROUND WATER

TO THE STATE ENGINEER OF OREGON:

I, D. B. MAXFIELD

of Box 27 County of Wasco
(Mailing address)

State of Oregon, do hereby make application for a certificate of registration as evidence of a right to appropriate ground water.

1. Source from which water is withdrawn is PUMP
(Flowing well, pump well, infiltration trench, or tunnel)

2. Location is: 2 miles S.E. of Turner
(Approximate distance and direction from nearest city or town)

and is more particularly described as follows:

(a) 1000 feet North & 2200 feet east from SW Corner Sec 3
(Give distance and bearing to corner of section or other legal subdivision)

being within SE 1/4 of SW 1/4 of Sec. 3, Twp. 9S, Rge. 2W
(Smallest legal subdivision) (N. or S.) (E. or W.)

or (b) within limits of recorded platted property, town or city:

in Lot _____, Block _____ of _____
(Name of plat or addition)

County of _____
(If within city or town, give name)

3. Construction Work was begun on SEPT 8 1952; was completed on SEPT 1953
(Date) (Date)

and the ground water claimed was first used for the purposes set out below on SEPT 1953
(Date)

since which time the water has been used INTERMITTENTLY DURING SEASON
(Continuously or intermittently)

from 1953 to 1957
(Date) (Date)

4. Quantity of water claimed and used is 80 gallons per minute; _____ acre feet per year.

5. Purpose or Purposes for which water is used IRRIGATION
(Domestic, irrigation, municipal, manufacturing, industrial, etc.)

6. Description of Well: Depth 50 feet. Type Drilled
(Dug or drilled)

diameter 10 inches. Elevation of ground at well site 330 feet, mean sea level.
(As near as known)

Depth to water table 8 feet.

7. Capacity of Well: 100 g.p.m. with 49 feet drawdown.

_____ g.p.m. with _____ feet drawdown.


Date of test 9-15-53

If Flowing Well: Measured discharge _____ g.p.m. on _____
(Date)

Shut-in pressure at ground surface _____ lbs. per sq. in. on _____
(Date)

Water is controlled by _____
(Cap, valve, etc.)

Township 9S Range 2W, W.M.
North

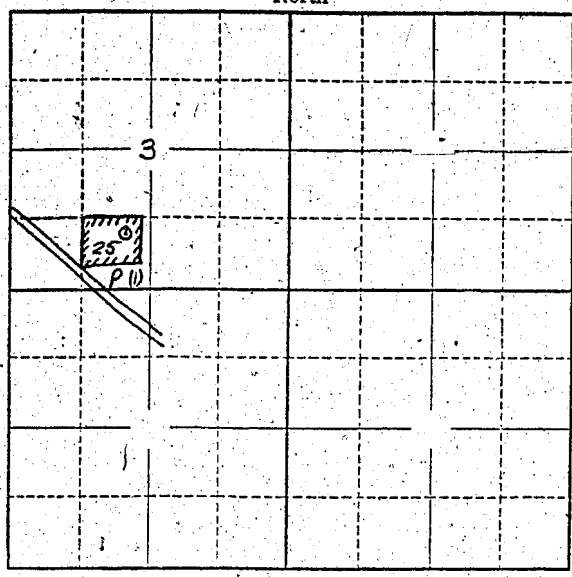

Locate well and acreage of irrigated land on plat.
Scale: 2" = 1 Mile

STATE OF OREGON
County of Marion } ss.

I, _____ being first duly sworn, do hereby certify that I have read the foregoing Registration Statement and that all of the items therein contained are true to the best of my knowledge and belief.

D. B. Masfield

(Signature of Registrant)

Subscribed and sworn to before me this 5th day of March, 1958

My commission expires 12th June 1961

W. S. Britholmer

(Notary Public)

(SEAL)

CERTIFICATE OF REGISTRATION

STATE OF OREGON
County of Marion } ss.

This is to certify that the foregoing Registration Statement was received in the office of the State Engineer on the 5th day of March, 1958, at 11:30 o'clock A. M. and has been duly recorded in said office in Book No. 6 of Registration Statements on page GR-1075

Witness my hand this 30th day of June, 1958

Laura A. Stanley

(State Engineer)

By _____
(Deputy)

GR 1075