RECEIVED
MAR 6 1958
STATE ENGINEER
SALEM, OREGON

REGISTRATION NO. GR-1116
CERTIFICATE NO. GR-1076

Registration Statement

OF CLAIMANT OF RIGHT TO APPROPRIATE GROUND WATER

(Under Chapter 708, Oregon Laws 1955.)

TO THE STATE ENGINEER OF OREGON:

I, Raymond L. Phillips,
of Salem Ore - RT 5, Box 80 County of Marion
State of Oregon, do hereby make application for a certificate of registration as evidence of a right to appropriate ground water.

1. **Source** from which water is withdrawn is Pump well
(Flowing well, pump well, infiltration trench, or tunnel)

2. **Location is:** 2 Miles East of 4 Corners on State St.
(Approximate distance and direction from nearest city or town)

and is more particularly described as follows:

(a) 1838 feet West and 542 feet South of N.E. Cor of the J.C. Ellingson donation land claim
(Give distance and bearing to corner of section or other legal subdivision)

being within NE NW Sec. 28 SW/4 of SW/4 of Sec. 28, Twp. 7 S (N. or S.), Rge. 2 W (E. or W.)
(Smallest legal subdivision)

or (b) within limits of recorded platted property, town or city:

in Lot ....., Block ..... of .....
(Name of plat or addition)

..... County of Marion
(If within city or town, give name)

3. **Construction Work** was begun on June 10th 1951 (Date); was completed on June 15th 1951 (Date)
and the ground water claimed was first used for the purposes set out below on June 17th 1951 (Date);
since which time the water has been used Continuously
(Continuously or intermittently)
from June 17th 1951 (Date) to Mar 1958 (Date)

4. **Quantity** of water claimed and used is 250 gallons per minute; [illegible] acre feet per year.

5. **Purpose or Purposes** for which water is used [illegible]
(Domestic, irrigation, municipal, manufacturing, industrial, etc.)

6. **Description of Well:** Depth 95 feet. Type Drilled
(Dug or drilled)
diameter 8 inches. Elevation of ground at well site 195 (As near as known) feet, mean sea level.
Depth to water table 21 feet.

7. **Capacity of Well:** 250 approx g.p.m. with [illegible] feet drawdown. As much as I can use
..... g.p.m. with ..... feet drawdown.

Date of test June 16th 1951

If Flowing Well: Measured discharge ..... g.p.m. on .....
(Date)

Shut-in pressure at ground surface ..... lbs. per sq. in. on .....
(Date)

Water is controlled by Gate valve
(Cap, valve, etc.)

8. **Casing:** (Give diameter, commercial specifications and depth below ground surface of each casing size.)

8 inch diameter 10' lengths Totaling 80' from Unknown to feet

inch diameter from to feet

inch diameter from to feet

inch diameter from to feet

Describe and show depth of shoe, plug, adapter, liner or other details: Unknown

9. **Perforated Casings or Screens:**

U N Known from to
(Number per foot and size of perforations, or describe screen)

from to

from to

from to

10. **Log of Well:** (Describe each stratum or formation clearly, indicate if water bearing, and give thickness and depth as indicated.)

MATERIAL	Thickness (Feet)	Depth to Bottom (Feet)
Log of well not available. At the time I drilling I was [illegible] Brewer and the owner [illegible] Hornsby and [illegible] By the Driller [illegible] furnished [illegible] the cost [illegible] the well [illegible]		

GR-1076

If log of well is not available, give name and address of driller. Ed E Evans

8225 Cutherland Rd North

11. **Infiltration Trench:** Covered or open .....

Dimensions: Length ..... ft. Minimum depth ..... ft. Maximum depth ..... ft.

Bottom width ..... ft. Discharge ..... g.p.m. Date of test .....

12. **Tunnel:** Type of lining .....

Dimensions: .....
(Length, course, and cross sectional size)

Position of water bearing stratum with reference to portal of tunnel .....

Log of tunnel: (Preceding table for log of well may be used, if desired. Give footage from portal and character of materials, as pertinent.)

13. **Pumping Equipment:**

(a) Pump Ser # WBB217 Sc W 221 Turbine 10 H.P. Capacity ..... g.p.m.
(Make, type and size)

(b) Motor 10 H.P. U.S. Electric 1750 RPM 3 phase 60 cy 220 volt 480
(Type and horsepower)
12 in Diam, Starter SCU Type - 18 in RPM Serial # 897480

14. **Location of area irrigated or to be irrigated, or place of use if for purposes other than irrigation.**

Township North or South	Range E. or W. of Willamette Meridian	Section	Forty-acre Tract	Number Acres To Be Irrigated	Date of Reclamation
-1 S	2W	32-29 37-28		~~30~~	June 1951
T7S	R2W.	28	SW 1/4 of SW 1/4	30 Total	" 1951

15. If the ground water supply is supplemental to an existing water supply, identification of any application for a permit, permit, certificate or adjudicated right to appropriate water made or held by the registrant.

application # 25978 Permit # 20360 on W Fork Little Pudding River

GR-1036

Township 7S Range 2W, W.M.

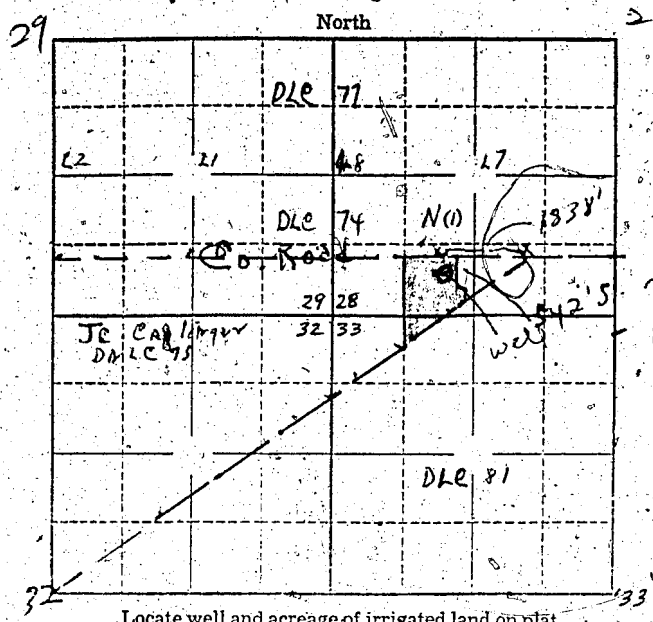

well is located 1338' west and 542' south of N.E. Cor of Caplinger DLC #75.

Locate well and acreage of irrigated land on plat.

Scale: 2" = 1 Mile

STATE OF OREGON
County of Marion } ss.

I, [illegible], being first duly sworn, do hereby certify that I have read the foregoing Registration Statement and that all of the items therein contained are true to the best of my knowledge and belief.

(Signature of Registrant)

Subscribed and sworn to before me this 5th day of March, 1958

My commission expires 1-30-59 Gloria J. Lieber (Notary Public)

(SEAL)

CERTIFICATE OF REGISTRATION

STATE OF OREGON
County of Marion } ss.

This is to certify that the foregoing Registration Statement was received in the office of the State Engineer on the ..... day of ....., 19..., at ..... o'clock ..... M. and has been duly recorded in said office in Book No. 6 of Registration Statements on page GR-1076

Witness my hand this 30th day of June, 19 58

(State Engineer)

By ..... (Deputy)

GR-1076