REGISTRATION NO. GR-1122

CERTIFICATE NO. GR-1082

STATE ENGINEER
SALEM, OREGON

Registration Statement

OF CLAIMANT OF RIGHT TO APPROPRIATE GROUND WATER

(Under Chapter 708, Oregon Laws 1955.)

TO THE STATE ENGINEER OF OREGON:

I, Elmer Johnson,

of Coburg, County of Lane

State of Oregon, do hereby make application for a certificate of registration as evidence of a right to appropriate ground water.

1. **Source** from which water is withdrawn is well
(Flowing well, pump well, infiltration trench or tunnel)

2. **Location** is: 2 miles west of Coburg
(Approximate distance and direction from nearest city or town);

and is more particularly described as follows:

(a) 2295.4 feet West & 231.5 feet North of N.1/4 Cor. John Mansfield D.L.C. No.59
(Give distance and bearing to corner of section or other legal subdivision)

being within N.W.1/4 of S.E.1/4 of Sec. 31, Twp. 16 S., Rge. 2 W.
(Smallest legal subdivision) (N. or S.) (E. or W.)

or (b) within limits of recorded platted property, town or city:

in Lot ....., Block ..... of .....
(Name of plat or addition)

..... County of .....
(If within city or town, give name)

3. **Construction Work** was begun on June 1950 (Date); was completed on June 1950 (Date)

and the ground water claimed was first used for the purposes set out below on June 1950 (Date),

since which time the water has been used Continuously
(Continuously or intermittently)

from June 1950 (Date) to Present (Date)

4. **Quantity** of water claimed and used is 92.57 gallons per minute: ..... acre feet per year.

5. **Purpose or Purposes** for which water is used Irrigation.
(Domestic, irrigation, municipal, manufacturing, industrial, etc.)

6. **Description of Well:** Depth 20 feet. Type Three 2½ inch pipes.
(Dug or drilled)

diameter 2½ inches. Elevation of ground at well site 375 feet, mean sea level
(As near as known)

Depth to water table unk feet.

7. **Capacity of Well:** ..... g.p.m. with ..... feet drawdown.

..... g.p.m. with ..... feet drawdown.

Date of test .....

If Flowing Well: Measured discharge ..... g.p.m. on .....
(Date)

Shut-in pressure at ground surface ..... lbs. per sq. in. on .....
(Date)

Water is controlled by .....
(Cap, valve, etc.)

8. **Casing:** (Give diameter, commercial specifications and depth below ground surface of each casing size.)

2½ inch diameter Gal Iron pipe from 0 to 20 feet

..... inch diameter ..... from ..... to ..... feet

..... inch diameter ..... from ..... to ..... feet

..... inch diameter ..... from ..... to ..... feet

Describe and show depth of shoe, plug, adapter, liner or other details: .....

9. **Perforated Casings or Screens:**

..... from ..... to .....
(Number per foot and size of perforations, or describe screen)

..... from ..... to .....

..... from ..... to .....

..... from ..... to .....

10. **Log of Well:** (Describe each stratum or formation clearly, indicate if water bearing, and give thickness and depth as indicated.)

MATERIAL	Thickness (Feet)	Depth to Bottom (Feet)

GR-1082

If log of well is not available, give name and address of driller. .....

.....

11. **Infiltration Trench:** Covered or open .....

Dimensions: Length ..... ft. Minimum depth ..... ft. Maximum depth ..... ft.

Bottom width ..... ft. Discharge ..... g.p.m. Date of test .....

12. **Tunnel:** Type of lining .....

Dimensions: .....
(Length, course, and cross sectional size)

Position of water bearing stratum with reference to portal of tunnel .....

.....

Log of tunnel: (Preceding table for log of well may be used, if desired. Give footage from portal and character of materials, as pertinent.)

13. **Pumping Equipment:**

(a) Pump 2 inch centrifugal. (Make, type and size) Capacity ..... g.p.m.

(b) Motor Chalmers Gas motor (Type and horsepower)

14. Location of area irrigated or to be irrigated, or place of use if for purposes other than irrigation.

Township North or South	Range E. or W. of Willamette Meridian	Section	Forty-acre Tract	Number Acres To Be Irrigated	Date of Reclamation
16.S.	2.W.	31	N.W.¼ S.E.¼	17.0	June 1950

15. If the ground water supply is supplemental to an existing water supply, identification of any application for a permit, permit, certificate or adjudicated right to appropriate water made or held by the registrant.

.....

.....

GR-1082

Township 16 S. Range 2 W., W.M.

North

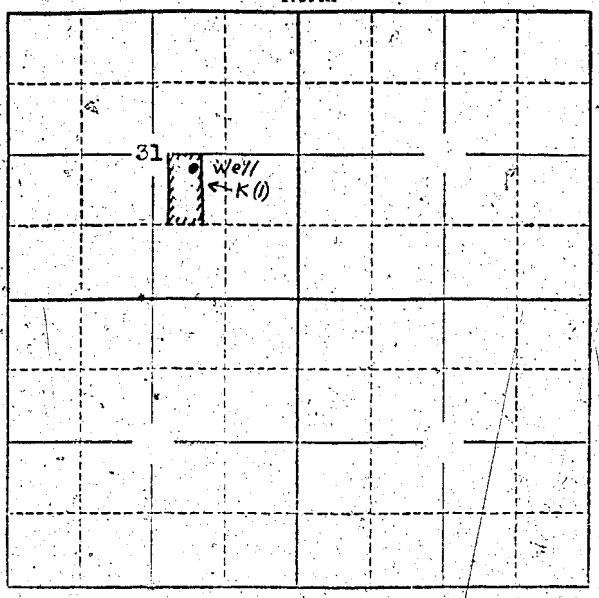

Locate well and acreage of irrigated land on plat.

Scale: 2" = 1 Mile

STATE OF OREGON
County of Lane } ss.

I, Elmer Johnson., being first duly sworn, do hereby certify that I have read the foregoing Registration Statement and that all of the items therein contained are true to the best of my knowledge and belief.

Elmer V. Johnson
(Signature of Registrant)

Subscribed and sworn to before me this 5 day of March, 1958.

My commission expires Mar. 12-1959 Gerry R. Wilcox
(Notary Public)

(SEAL)

CERTIFICATE OF REGISTRATION

STATE OF OREGON
County of Marion } ss.

This is to certify that the foregoing Registration Statement was received in the office of the State Engineer on the 7 day of March, 19 58, at 5 o'clock A M. and has been duly recorded in said office in Book No. 6 of Registration Statements on page GR-1082

xx ~~Certificate is expected to be issued, and the water completely applied to~~

Witness my hand this 20 day of August, 19 58.

Lewis A. Stanley
(State Engineer)

$15.00

By
(Deputy)

GR-1082