

Registration Statement

OF CLAIMANT OF RIGHT TO APPROPRIATE GROUND WATER

Valley No. 1

TO THE STATE ENGINEER OF OREGON:

I, A.W. CROCKER

of 2810 Pringle Bl County of Marion

State of Oregon, do hereby make application for a certificate of registration as evidence of a right to appropriate ground water.

1. Source from which water is withdrawn is Pump Well

2. Location is: 3 Mi. South of Brook Vista

and is more particularly described as follows:

(a) N. 38° 30' E 2042.05 ft. Corner of Sec 24 3 Twp 16 S Rge 12 W

being within Polk County of Sec 24 3, Twp. 16 S, Rge. 12 W

or (b) within limits of recorded platted property, town or city:

in Lot _____, Block _____ of _____

County of _____

3. Construction Work was begun on _____; was completed on July 1937

and the ground water claimed was first used for the purposes set out below on 1937

since which time the water has been used Continuously except when Company by City

from 1937 to 1957

4. Quantity of water claimed and used is 200 gallons per minute; _____ acre feet per year.

5. Purpose or Purposes for which water is used irrigation

6. Description of Well: Depth 45 feet. Type drilled

diameter 12 inches. Elevation of ground at well site 177 feet, mean sea level.

Depth to water table 2-5 feet.

7. Capacity of Well: 300 g.p.m. with 35 feet drawdown.

_____ g.p.m. with _____ feet drawdown.

Date of test _____

If Flowing Well: Measured discharge _____ g.p.m. on _____

Shut-in pressure at ground surface _____ lbs. per sq. in. on _____

Water is controlled by _____

If log of well is not available, give name and address of driller. Slapper Independence

11. Infiltration Trench: Covered or open
Dimensions: Length ft. Minimum depth ft. Maximum depth ft.
Bottom width ft. Discharge g.p.m. Date of test
12. Tunnel: Type of lining
Dimensions:
(Length, course, and cross sectional size)
Position of water bearing stratum with reference to portal of tunnel

Log of tunnel: (Preceding table for log of well may be used, if desired. Give footage from portal and character of materials, as pertinent.)

13. Pumping Equipment:
(a) Pump: Cent - 10 Horse Electric Motor Capacity 300 g.p.m.
(Make, type and size)
(b) Motor
(Type and horsepower)


14. Location of area irrigated or to be irrigated, or place of use if for purposes other than irrigation.

Township North or South	Range E. or W. of Willamette Meridian	Section	Forty-acre Tract	Number Acres To Be Irrigated	Date of Reclamation
10 S	4 W	3	SE $\frac{1}{4}$ of NE $\frac{1}{4}$	50	1937
"	"	3	NE $\frac{1}{4}$ of SE $\frac{1}{4}$	17.00	1937
"	"	2	N. W. $\frac{1}{4}$ of SW $\frac{1}{4}$	10.50	1937
				28.00	



15. If the ground water supply is supplemental to an existing water supply, identification of any application for a permit, permit, certificate or adjudicated right to appropriate water made or held by the registrant.

Township 105 Range 4W W.M. North

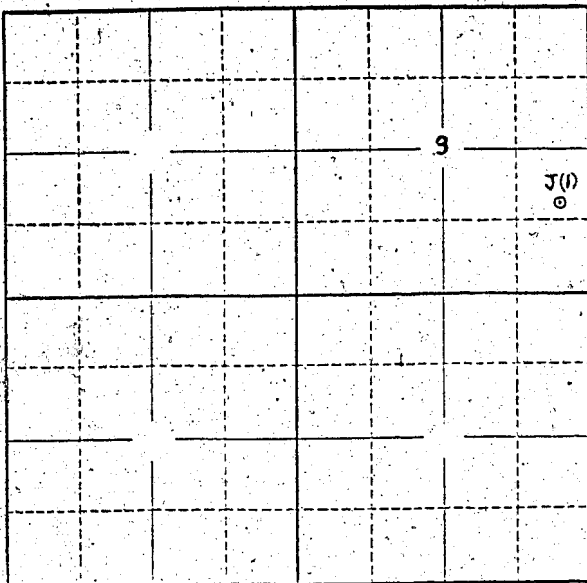

Locate well and acreage of irrigated land on plat. Scale: 2" = 1 Mile

STATE OF OREGON

County of Marion

ss.

I, A. W. Crocker, being first duly sworn, do hereby certify that I have read the foregoing Registration Statement and that all of the items therein contained are true to the best of my knowledge and belief.

A. W. Crocker
(Signature of Registrant)

Subscribed and sworn to before me this 10 day of March, 1958.

My commission expires Sept. 9, 1960

Charles J. [illegible]
(Notary Public)

(SEAL)

CERTIFICATE OF REGISTRATION

STATE OF OREGON

County of Marion

ss.

This is to certify that the foregoing Registration Statement was received in the office of the State Engineer on the 10 day of March, 1958, at 10:00 o'clock A.M. and has been duly recorded in said office in Book No. 6 of Registration Statements on page GR-1085

Witness my hand this 20 day of August, 1958

Lewis A. Stanley
(State Engineer)

By _____ (Deputy)