

RECEIVED
MAR 7 1953
STATE ENGINEER
SALEM, OREGON

Registration No. GR - 1133

Certificate No. GR - 1093

Registration Statement

OF CLAIMANT OF RIGHT TO APPROPRIATE GROUND WATER

TO THE STATE ENGINEER OF OREGON:

I, Andrew J. Gilmore & Mabel Gilmore
of Rt 3 Box 215 Melton Freewater County of Umatilla
State of Oregon, do hereby make application for a certificate of registration as evidence
of a right to appropriate ground water.

- 1. Source from which water is withdrawn is pump well
(Flowing well, pump well, infiltration trench, or tunnel)
- 2. Location is: 4 mile North of Melton Freewater Oregon
(Approximate distance and direction from nearest city or town)

and is more particularly described as follows:
558' ~~375'~~ south of N. line of Section 26 and 75' west of N. and S. center
(a) line of N.E. 1/4 of section 26
(Give distance and bearing to corner of section or other legal subdivision)
being within N.E. 1/4 NW. of NE of Sec. 26, Twp. 4 N., Rge. 35 E. 24 M.
(Smallest legal subdivision) (N. or S.) (E. or W.)

or (b) within limits of recorded platted property, town or city: _____

in Lot _____ Block _____ of _____
(Name of plat or addition)

County of _____
(If within city or town, give name)

3. Construction Work was begun on Approx to 1909; was completed on Prior to 1909
(Date) (Date)
and the ground water claimed was first used for the purposes set out below on Prior to 1909
(Date)
since which time the water has been used Intermittently
(Continuously or intermittently)

from March to Oct 31
(Date) (Date)

4. Quantity of water claimed and used is 100 gallons per minute; _____ acre
feet per year.

5. Purpose or Purposes for which water is used irrigation
(Domestic, irrigation, municipal, manufacturing, industrial, etc.)

6. Description of Well: Depth 25 feet. Type Dug
(Dug or drilled)
diameter 5 ft square inches. Elevation of ground at well site 220 ft feet, mean sea level.
(As near as known)
Depth to water table 15 feet.

7. Capacity of Well: _____ g.p.m. with _____ feet drawdown.
_____ g.p.m. with _____ feet drawdown.


Date of test 2 Feb

If Flowing Well: Measured discharge _____ g.p.m. on _____
(Date)

Shut-in pressure at ground surface _____ lbs. per sq. in. on _____
(Date)

Water is controlled by _____
(Cap, valve, etc.)

Township Range W.M.
North

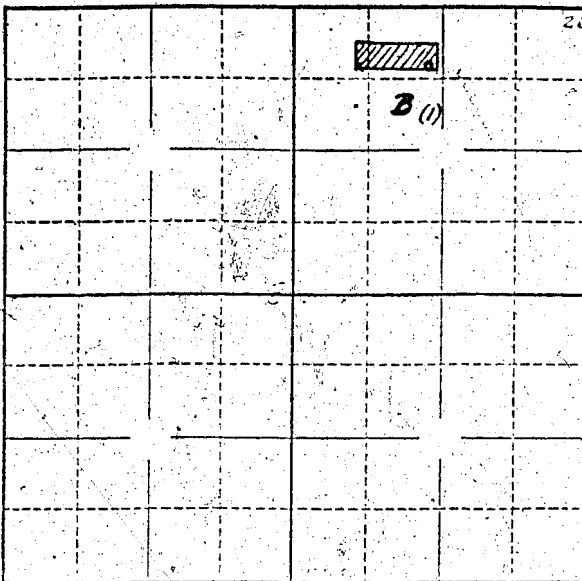

Locate well and acreage of irrigated land on plat.

Scale: $\frac{1}{2}$ " = 1 Mile

STATE OF OREGON






My commission expires _____

(Notary Public)

(SEAL)

CERTIFICATE OF REGISTRATION

STATE OF OREGON

County of Marion

ss.



Lewis A. Stanley
(State Engineer)

By _____

(Deputy)

GR - 1093