

Registration No. GR- 1135

Certificate No. GR - 1195

STATE ENGINEER
SALEM, OREGON

Registration Statement

OF CLAIMANT OF RIGHT TO APPROPRIATE GROUND WATER

TO THE STATE ENGINEER OF OREGON:

I, Herman Miller,

of Ft. 3, Box 97 Wilton-Freerter County of Umatilla
(Mailing address)

State of Oregon, do hereby make application for a certificate of registration as evidence of a right to appropriate ground water.

1. Source from which water is withdrawn is PUMED well
(Flowing well, pump well, infiltration trench, or tunnel)

2. Location is: four N. orth of Freerter, on old M.E. highway
(Approximate distance and direction from nearest city or town)

and is more particularly described as follows: 200' W X 15' N from the

(a) beginning at the SE corner of the NE quarter of the Southwest quarter of
(Give distance and bearing to corner of section or other legal subdivision)

being within NE & SW 1/4 of Sec. 14, Twp. 6 North, Rge. 35 E.W.M.
(Smallest legal subdivision) (N. or S.) (E. or W.)

or (b) within limits of recorded platted property, town or city:

in Lot _____, Block _____ of _____
(Name of plat or addition)

County of _____
(If within city or town, give name)

3. Construction Work was begun on Prior to 1910; was completed on 1910
(Date) (Date)

and the ground water claimed was first used for the purposes set out below on 1910
(Date)

since which time the water has been used intermittently
(Continuously or intermittently)

from May to Sept.
(Date) (Date)

4. Quantity of water claimed and used is 100 gallons per minute; 50 acre feet per year.

5. Purpose or Purposes for which water is used: irrigation
(Domestic, irrigation, municipal, manufacturing, industrial, etc.)

6. Description of Well: Depth 18 feet. Type dug
(Dug or drilled)
diameter 60 inches. Elevation of ground at well site 925 feet, mean sea level.
(As near as known)

Depth to water table 8 feet.

7. Capacity of Well: 170 g.p.m. with 16 feet drawdown.

_____ g.p.m. with _____ feet drawdown.

Date of test _____


If Flowing Well: Measured discharge _____ g.p.m. on _____
(Date)

Shut-in pressure at ground surface _____ lbs. per sq. in. on _____
(Date)

Water is controlled by _____
(Cap, valve, etc.)

Section 14

Township 6N Range 35 W.M.
North

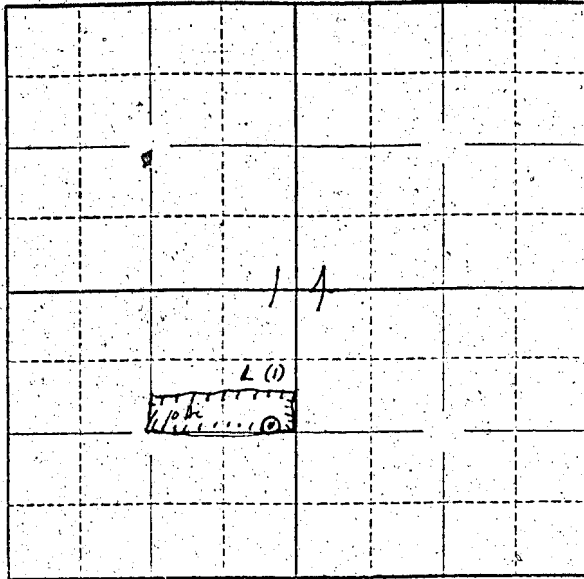

Locate well and acreage of irrigated land on plat.
Scale: 2" = 1 Mile

STATE OF OREGON

County of Umatilla } ss.

I, Herman Miller, being first duly sworn, do hereby certify that I have read the foregoing Registration Statement and that all of the items therein contained are true to the best of my knowledge and belief.

Herman Miller
(Signature of Registrant)

Subscribed and sworn to before me this 6th day of March, 1958

My commission expires Sept. 8, 1960
Charles E. Schuler
(Notary Public)

(SEAL)

CERTIFICATE OF REGISTRATION

STATE OF OREGON

County of Marion } ss.

This is to certify that the foregoing Registration Statement was received in the office of the State Engineer on the 11th day of March, 1958, at 1:15 o'clock PM and has been duly recorded in said office in Book No. 6 of Registration Statements on page GR-1195.

Witness my hand this 20 day of August, 1958

Laura A. Stearns
(State Engineer)

By _____
(Deputy)

GR - 1095