

RECEIVED  
MAY 1 1958  
STATE ENGINEER  
SALE, OREGON

Registration No. GR - 1139

Certificate No. GR - 1099

# Registration Statement

## OF CLAIMANT OF RIGHT TO APPROPRIATE GROUND WATER

TO THE STATE ENGINEER OF OREGON:

I, John L. Richardt

of Milton-Beavater, Rt. 2, box 199, County of Umatilla  
(Mailing address)

State of OREGON, do hereby make application for a certificate of registration as evidence of a right to appropriate ground water.

1. Source from which water is withdrawn is Pump well  
(Flowing well, pump well, infiltration trench, or tunnel)

2. Location is: 3/4 mi. N.W. of Umatilla, Ore.  
(Approximate distance and direction from nearest city or town)

and is more particularly described as follows:

(a) 150 ft. North, 7 ft. East of center of Sec. 24, Twp. 6 N., Rge. 30 E.  
(Give distance and bearing to corner of section or other legal subdivision)

being within S.E. 1/4 of N. 1/4 of Sec. 24, Twp. 6 N., Rge. 30 E.  
(Smallest legal subdivision) (N. or S.) (E. or W.)

or (b) within limits of recorded platted property, town or city:

in Lot \_\_\_\_\_, Block \_\_\_\_\_ of \_\_\_\_\_  
(Name of plat or addition)

County of \_\_\_\_\_  
(If within city or town, give name)

3. Construction Work was begun on before 1918; was completed on before 1918  
(Date) (Date)

and the ground water claimed was first used for the purposes set out below on 1918  
(Date)

since which time the water has been used continuously from 1918 to 1957  
(Continuously or intermittently)

from July 1st to Oct. 1st  
(Date) (Date)

4. Quantity of water claimed and used is 300 gallons per minute; 1.2 acre feet per year.

5. Purpose or Purposes for which water is used crop irrigation  
(Domestic, irrigation, municipal, manufacturing, industrial, etc.)

6. Description of Well: Depth 50 feet. Type drilled  
(Dug or drilled)

diameter \_\_\_\_\_ inches. Elevation of ground at well site 750 feet, mean sea level.  
(As near as known)

Depth to water table 15 feet.

7. Capacity of Well: 300 g.p.m. with 20 feet drawdown.  
\_\_\_\_\_ g.p.m. with \_\_\_\_\_ feet drawdown.

Date of test estimated

If Flowing Well: Measured discharge \_\_\_\_\_ g.p.m. on \_\_\_\_\_  
(Date)


Shut-in pressure at ground surface \_\_\_\_\_ lbs. per sq. in. on \_\_\_\_\_  
(Date)

Water is controlled by \_\_\_\_\_  
(Cap, valve, etc.)





Township 6 N Range 34 E.W.M.  
North

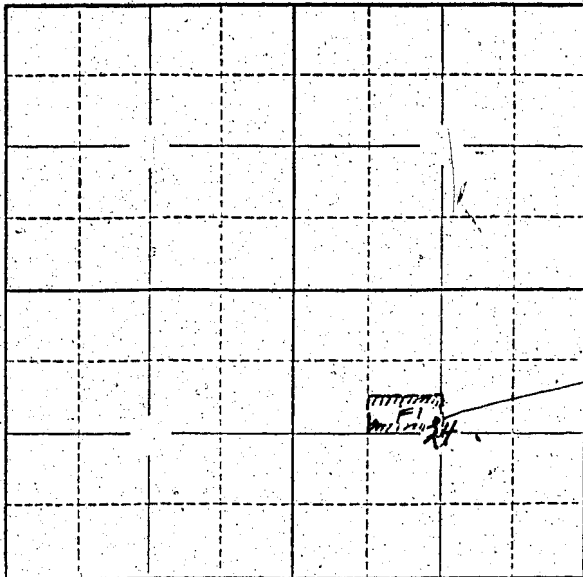

Well Location  
150 feet North  
7 feet West of  
Center of Sec 24

Locate well and acreage of irrigated land on plat.  
Scale: 2" = 1 Mile

STATE OF OREGON

County of Marion } ss.

I, James B. Richards, being first duly sworn, do hereby certify that I have read the foregoing Registration Statement and that all of the items therein contained are true to the best of my knowledge and belief.

.....  
(Signature of Registrant)

Subscribed and sworn to before me this 14 day of August, 1955.

My commission expires Aug 15 1956 .....  
(Notary Public)

(SEAL)

**CERTIFICATE OF REGISTRATION**

STATE OF OREGON

County of Marion } ss.

This is to certify that the foregoing Registration Statement was received in the office of the State Engineer on the 16 day of March, 1955, at 8:10 o'clock A.M. and has been duly recorded in said office in Book No. 6 of Registration Statements on page GR-1099.

Witness my hand this 20 day of August, 1958.

Lewis A. Stanley  
(State Engineer)

By .....  
(Deputy)