


Registration No. GR - 1146

Certificate No. GR - 1105

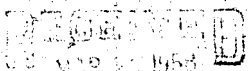

# Registration Statement

## STATE OF CLAIMANT OF RIGHT TO APPROPRIATE GROUND WATER SALEM, OREGON

TO THE STATE ENGINEER OF OREGON:

I, W J Miller  
of Rte 2 Box 12 Milton Freewater County of Linn  
(Mailing address)

State of Oregon, do hereby make application for a certificate of registration as evidence of a right to appropriate ground water.

- Source from which water is withdrawn is pump well  
(Flowing well, pump well, infiltration trench, or tunnel)
- Location is: 1 1/2 Miles Northwest of Milton Freewater  
(Approximate distance and direction from nearest city or town)

and is more particularly described as follows:

(a) 1' N E 20' W of SE cor. of NE 1/4 SE 1/4 Sec. 34  
(Give distance and bearing to corner of section or other legal subdivision)  
being within NE 1/4 of SE 1/4 of Sec. 34 Twp. 6N Rge. 35E  
(Smallest legal subdivision) (N. or S.) (E. or W.)

or (b) within limits of recorded platted property, town or city:  
in Lot \_\_\_\_\_, Block \_\_\_\_\_ of \_\_\_\_\_  
(Name of plat or addition)

County of \_\_\_\_\_  
(If within city or town, give name)

3. Construction Work was begun on 1908; was completed on Early 1920's  
(Date) (Date)

and the ground water claimed was first used for the purposes set out below on 1908  
(Date)

since which time the water has been used CONTINUOUSLY  
(Continuously or intermittently)

from 1908 to 1957  
(Date) (Date)

4. Quantity of water claimed and used is 300 gallons per minute; 170 acre feet per year.

5. Purpose or Purposes for which water is used IRRIGATION

(Domestic, irrigation, municipal, manufacturing, industrial, etc.)

6. Description of Well: Depth 100 feet. Type Dug 48 Drilled 52  
72 inches dug part (Dug or drilled)  
diameter 8 inches. Elevation of ground at well site 950 feet, mean sea level.  
Below (As near as known)  
Depth to water table 20 feet.

7. Capacity of Well: \_\_\_\_\_ g.p.m. with \_\_\_\_\_ feet drawdown.

\_\_\_\_\_ g.p.m. with \_\_\_\_\_ feet drawdown.

Date of test \_\_\_\_\_

If Flowing Well: Measured discharge Not Flowing g.p.m. on \_\_\_\_\_  
(Date)


Shut-in pressure at ground surface \_\_\_\_\_ lbs. per sq. in. on \_\_\_\_\_  
(Date)

Water is controlled by \_\_\_\_\_  
(Cap. valve, etc.)





Township 6 N Range 35 E W.M. Section 34  
~~South~~ East 14

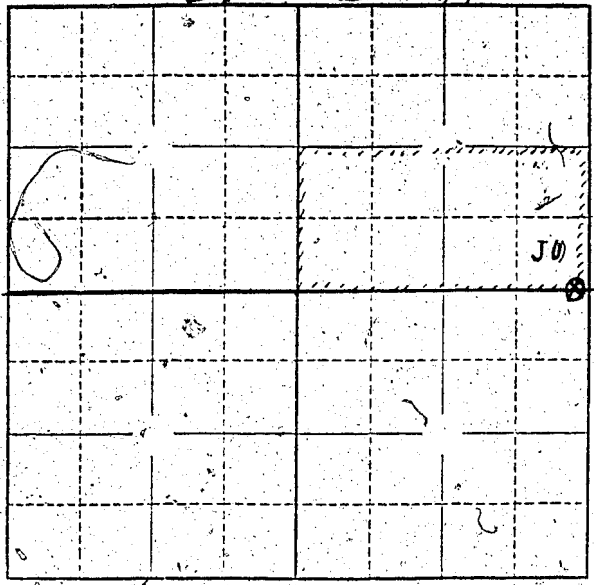

Well located  
 20' west of  
 SE corner of  
 Property

Locate well and acreage of irrigated land on plat.  
 Scale: 8" = 1 Mile

STATE OF OREGON }  
 County of Umatilla } ss.

I, Walter Miller, being first duly sworn, do hereby certify that I have read the foregoing Registration Statement and that all of the items therein contained are true to the best of my knowledge and belief.

W. J. Miller  
 (Signature of Registrant)

Subscribed and sworn to before me this 6 day of March, 1958

My commission expires Sept 8, 1960  
Chas. J. White  
 (Notary Public)

(SEAL)

**CERTIFICATE OF REGISTRATION**

STATE OF OREGON }  
 County of Marion } ss.

This is to certify that the foregoing Registration Statement was received in the office of the State Engineer on the 16 day of March, 1958, at 8:00 o'clock A. M. and has been duly recorded in said office in Book No. 6 of Registration Statements on page GR-1105

Witness my hand this 20 day of August, 1958  
Lewis A. Stanley  
 (State Engineer)

By \_\_\_\_\_  
 (Deputy)

GR-1105