

**Registration Statement****OF CLAIMANT OF RIGHT TO APPROPRIATE GROUND WATER**

(Under Chapter 708, Oregon Laws 1955.)

**TO THE STATE ENGINEER OF OREGON:**I, Earl B. Huckstepof Salem (4725 Swingla Rd.) County of MarionState of Oregon do hereby make application for a certificate of registration as evidence of a right to appropriate ground water.1. Source from which water is withdrawn is Pump well  
(Flowing well, pump well, infiltration trench, or tunnel)2. Location is: Three Miles N.E. of Salem  
(Approximate distance and direction from nearest city or town)

and is more particularly described as follows:

(a) Approx. 960' east and 415' north of the S.W. Cor. John C. Herren D.L.C #53  
(Give distance and bearing to corner of section or other legal subdivision)being within S.E. 1/4 of N.E. 1/4 of Sec. 19, Twp. 7 S., Rge. 2 W.  
(Smallest legal subdivision) (N. or S.) (E. or W.)or (b) within limits of recorded platted property, town or city: McNary Fruit & Garden Tracts  
in Lot E. 1/2 of the E. 1/2 of Lots 7&8 and all of 9 of the above.  
Block \_\_\_\_\_ of \_\_\_\_\_  
(Name of plat or addition)County of Marion

(If within city or town, give name)

3. Construction Work was begun on Sept. 1951, was completed on Sept. 1951  
(Date) (Date)and the ground water claimed was first used for the purposes set out below on Sept. 1951  
(Date)since which time the water has been used Each season  
(Continuously or intermittently)from Sept. 1951 to Date  
(Date) (Date)4. Quantity of water claimed and used is 100 to 125 gallons per minute; \_\_\_\_\_ acre  
feet per year.5. Purpose or Purposes for which water is used Irrigation

(Domestic, irrigation, municipal, manufacturing, industrial, etc.)

6. Description of Well: Depth 120 feet. Type Drilled

(Dug or drilled)

diameter 8" inches. Elevation of ground at well site Approx. 200' feet, mean sea level.

(As near as known)

Depth to water table 20' feet.7. Capacity of Well: 400 g.p.m. with 60 feet drawdown.

\_\_\_\_\_ g.p.m. with \_\_\_\_\_ feet drawdown:

Date of test Sept. 1951

If Flowing Well: Measured discharge \_\_\_\_\_ g.p.m. on \_\_\_\_\_

(Date)

Shut-in pressure at ground surface \_\_\_\_\_ lbs. per sq. in. on \_\_\_\_\_

(Date)

Water is controlled by \_\_\_\_\_


(Cap, valve, etc.)





Township 7. S Range 2. W, W.M.

North

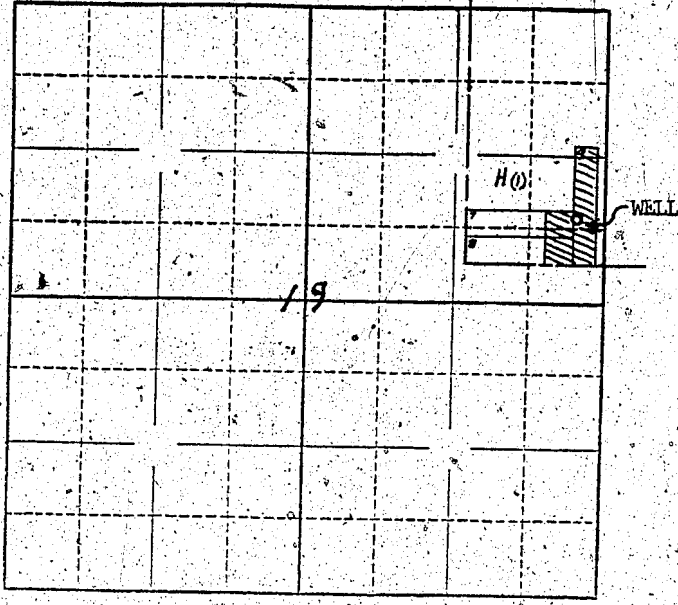

Locate well and acreage of irrigated land on plat.

Scale:  $\frac{1}{4}$ " = 1 Mile  
 $\frac{1}{4}$ " = "

STATE OF OREGON

County of Marion } ss.

I, Earl B. Huchstedt, being first duly sworn, do hereby certify that I have read the foregoing Registration Statement and that all of the items therein contained are true to the best of my knowledge and belief.

Earl B. Huchstedt  
(Signature of Registrant)

Subscribed and sworn to before me this 9th day of February, 1956.

My commission expires Nov 15th 1956  
H. J. ...  
(Notary Public)

(SEAL)

CERTIFICATE OF REGISTRATION

STATE OF OREGON

County of Marion } ss.

This is to certify that the foregoing Registration Statement was received in the office of the State Engineer on the 15th day of February, 1956, at 10:40 o'clock A. M. and has been duly recorded in said office in Book No. 1 of Registration Statements on page GR-106.C

Construction shall be completed by 15 1956, and the water 15 completely applied to beneficial use by 19 1956.

Witness my hand this 12th day of April, 1956.

Luirs A. Stanley  
(State Engineer)

By \_\_\_\_\_  
(Deputy)

GR-106.C