

RECEIVED
MAR 10 1958
STATE ENGINEER

Registration Statement

Registration No. GR - 1156
Certificate No. GR - 1120

OF CLAIMANT OF RIGHT TO APPROPRIATE GROUND WATER

TO THE STATE ENGINEER OF OREGON:

I, J.E. Bill and Anna M. Bill
of Milton, Oregon County of Umatilla
State of Oregon, do hereby make application for a certificate of registration as evidence
of a right to appropriate ground water. # 2

1. Source from which water is withdrawn is Pump Well
(Flowing well, pump well, infiltration trench, or tunnel)
2. Location is: 1/2 mile to north
(Approximate distance and direction from nearest city or town)

and is more particularly described as follows:

(a) 50 Ft West & 15 Ft North of SE Quarter Sec. Corner
(Give distance and bearing to corner of section or other legal subdivision)
being within SE 1/4 of SE 1/4 of Sec. 34, Twp. 6N, Rge. 55E
(Smallest legal subdivision) (N. or S.) (E. or W.)
or (b) within limits of recorded platted property, town or city:
in Lot _____, Block _____ of _____
(Name of plat or addition)

(If within city or town, give name)

County of _____

3. Construction Work was begun on 1908; was completed on 1908
(Date) (Date)
and the ground water claimed was first used for the purposes set out below on 1908
(Date)
since which time the water has been used Irrigation
(Continuously or intermittently)
from 1918 to 1957
(Date) (Date)

4. Quantity of water claimed and used is 200 gallons per minute; 80 acre
feet per year.

5. Purpose or Purposes for which water is used

Irrigation
(Domestic, irrigation, municipal, manufacturing, industrial, etc.)

6. Description of Well: Depth 75 feet. Type Dug 35 Ft Drilled 40
(Dug or drilled)
diameter 6 inches. Elevation of ground at well site 950 feet, mean sea level.
(As near as known)
Depth to water table 10 feet.

7. Capacity of Well: 200 g.p.m. with 10 feet drawdown.
g.p.m. with _____ feet drawdown.

Date of test _____

If Flowing Well: Measured discharge _____ g.p.m. on _____
(Date)


Shut-in pressure at ground surface _____ lbs. per sq. in. on _____
(Date)

Water is controlled by _____
(Cap, valve, etc.)

SE 1/4 of Section 34

Township 6N Range 35E, W.M.
North

34

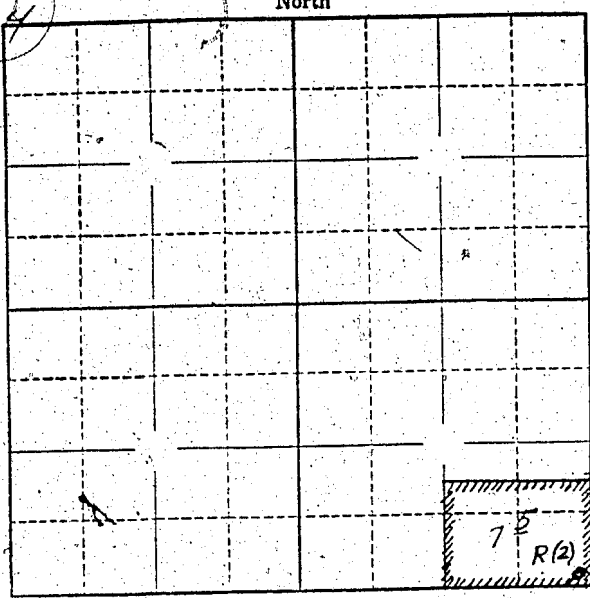

Well location
50 FT West side
15 FT North of
SE corner
of the Quarter
section

Locate well and acreage of irrigated land on plat.
Scale: 2" = 1 Mile

STATE OF OREGON }
County of Umatilla } ss.

I, [Signature], being first duly sworn, do hereby certify that I have read the foregoing Registration Statement and that all of the items therein contained are true to the best of my knowledge and belief.

[Signature]
(Signature of Registrant)

Subscribed and sworn to before me this 6 day of March, 1958

My commission expires Sept. 8, 1960
(Notary Public)

(SEAL)

CERTIFICATE OF REGISTRATION

STATE OF OREGON }
County of Marion } ss.

This is to certify that the foregoing Registration Statement was received in the office of the State Engineer on the 6 day of March, 1958, at 1:00 o'clock P. M. and has been duly recorded in said office in Book No. 6 of Registration Statements on page GR-1120

Witness my hand this 20 day of August, 1958
[Signature]
(State Engineer)

By _____
(Deputy)

GR-1120