RECEIVED
MAR 1 1958
STATE ENGINEER
SALEM, OREGON

Registration No. GR – 1157

Certificate No. GR – 1121

Registration Statement

OF CLAIMANT OF RIGHT TO APPROPRIATE GROUND WATER

TO THE STATE ENGINEER OF OREGON:

I, C E Eyler

of Milton Freewater (Mailing address) County of Umatilla

State of Ore, do hereby make application for a certificate of registration as evidence of a right to appropriate ground water.

1. **Source** from which water is withdrawn is Well (pump) (Flowing well, pump well, infiltration trench, or tunnel)

2. **Location** is: 1 3/4 miles Southeast (Approximate distance and direction from nearest city or town) of Umatilla

and is more particularly described as follows: Deed includes 10'x20' plot in S.E corner of 40 A. for well location. Also right of way for underground pipe to irrigated 20 A.

(a) S.W.S.E.S.E. Sec. 18 (Give distance and bearing to corner of section or other legal subdivision)

being within NW¼ of NE¼ (Smallest legal subdivision) of Sec. 29, Twp. 6 N. (N. or S.), Rge. 35 E. (E. or W.)

or (b) within limits of recorded platted property, town or city:

in Lot ....., Block ..... of ..... (Name of plat or addition)

..... (If within city or town, give name) County of .....

3. **Construction Work** was begun on 1919 (Date); was completed on 1919 (Date)

and the ground water claimed was first used for the purposes set out below on 1919 (Date),

since which time the water has been used continuously (Continuously or intermittently)

from March 15th (Date) to October 15th (Date).

4. **Quantity** of water claimed and used is 250 gallons per minute; ..... acre feet per year.

5. **Purpose or Purposes** for which water is used Irrigation (Domestic, irrigation, municipal, manufacturing, industrial, etc.)

6. **Description of Well:** Depth 28 feet. Type Dug (Dug or drilled)

diameter 5' X 5' ~~inches~~ feet. Elevation of ground at well site 825 (As near as known) feet, mean sea level.

Depth to water table 13 feet, (March 1st)

7. **Capacity of Well:** 250 g.p.m. with 10 feet drawdown. Late in season.

..... g.p.m. with ..... feet drawdown.

Date of test None

If Flowing Well: Measured discharge ..... g.p.m. on ..... (Date)

Shut-in pressure at ground surface ..... lbs. per sq. in. on ..... (Date)

Water is controlled by ..... (Cap, valve, etc.)

8. **Casing:** (Give diameter, commercial specifications and depth below ground surface of each casing size.)

5'x5' ~~inch~~ diameter [illegible] from [illegible] to [illegible] feet

..... inch diameter ..... from ..... to ..... feet

..... inch diameter ..... from ..... to ..... feet

..... inch diameter ..... from ..... to 0 feet

Describe and show depth of shoe, plug, adapter, liner or other details: .....

9. **Perforated Casings or Screens:**

None ..... from ..... to .....
(Number per foot and size of perforations, or describe screen)

..... from ..... to .....

..... from ..... to .....

..... from ..... to .....

10. **Log of Well:** (Describe each stratum or formation clearly, indicate if water bearing, and give thickness and depth as indicated.)

MATERIAL	Thickness (Feet)	Depth to Bottom (Feet)
Gravel & Sand	0	[illegible]
Cement Gravel	11	[illegible]

GR 1121

If log of well is not available, give name and address of driller. .....

.....

11. **Infiltration Trench:** Covered or open .....

Dimensions: Length ..... ft. Minimum depth ..... ft. Maximum depth ..... ft.

Bottom width ..... ft. Discharge ..... g.p.m. Date of test .....

12. **Tunnel:** Type of lining .....

Dimensions: ..... (Length, course, and cross sectional size)

Position of water bearing stratum with reference to portal of tunnel .....

.....

Log of tunnel: (Preceding table for log of well may be used, if desired. Give footage from portal and character of materials, as pertinent.)

13. **Pumping Equipment:**

(a) Pump Westinghouse type CSP. 2 inch (Make, type and size) Capacity 250 g.p.m. with open discharge.

(b) Motor 5 H.P. 60 cycle 3 phase 2900 R.P.M. (Type and horsepower)

14. Location of area irrigated or to be irrigated, or place of use if for purposes other than irrigation.

Township North or South	Range E. or W. of Willamette Meridian	Section	Forty-acre Tract	Number Acres To Be Irrigated	Date of Reclamation
6 N.	35 E.	29	West ½ NW. of NE.	20	?

15. If the ground water supply is supplemental to an existing water supply, identification of any application for a permit, permit, certificate or adjudicated right to appropriate water made or held by the registrant.

.....

.....

GR 1121

Township 6 N. Range 35 E. W.M.

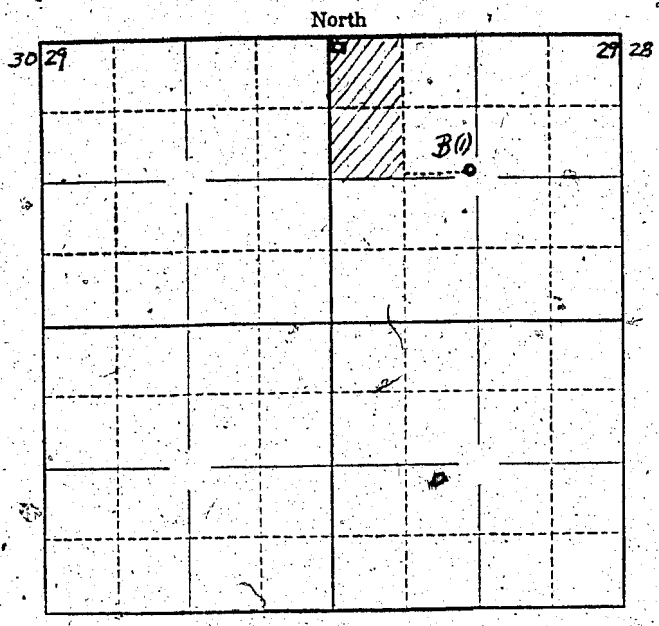

Locate well and acreage of irrigated land on plat.

Scale: 4 — 1 Mile

STATE OF OREGON }
County of [illegible] } ss.

I, [illegible], being first duly sworn, do hereby certify that I have read the foregoing Registration Statement and that all of the items therein contained are true to the best of my knowledge and belief.

[illegible]
(Signature of Registrant)

Subscribed and sworn to before me this [illegible] day of [illegible], 19[illegible].

My commission expires [illegible]
(Notary Public)

(SEAL)

CERTIFICATE OF REGISTRATION

STATE OF OREGON }
County of Marion } ss.

This is to certify that the foregoing Registration Statement was received in the office of the State Engineer on the [illegible] day of [illegible], 19[illegible], at [illegible] o'clock [illegible] M. and has been duly recorded in said office in Book No. 6 of Registration Statements on page GR-1121

Witness my hand this 20 day of August 19 58

Lewis A. Stanley
(State Engineer)

By [illegible]
(Deputy)

GR-1121