

Registration Statement

OF CLAIMANT OF RIGHT TO APPROPRIATE GROUND WATER

(Under Chapter 708, Oregon Laws 1955.)

TO THE STATE ENGINEER OF OREGON:

I, Carter J. Keene
of Herwais Ore County of Marion
State of Oregon, do hereby make application for a certificate of registration as evidence of a right to appropriate ground water.

1. Source from which water is withdrawn is Pump Well
(flowing well, pump well, infiltration trench, or tunnel)

2. Location is: 5 miles West, of Herwais Ore
(Approximate distance and direction from nearest city or town)

and is more particularly described as follows:

(a) 750 feet East and 400 feet south from west 1/4 corner of section 30.
(Give distance and bearing to corner of section or other legal subdivision)

being within NW 1/4 of SW 1/4 of Sec. 30, Twp. 5S, Rge. 2W
(Smallest legal subdivision) (N. or S.) (E. or W.)

or (b) within limits of recorded platted property, town or city:

in Lot _____ Block _____ of _____
(Name of plat or addition)

County of _____
(If within city or town, give name)

3. Construction Work was begun on 1945; was completed on 1945
(Date) (Date)

and the ground water claimed was first used for the purposes set out below on 1945
(Date)

since which time the water has been used Seasonally
(Continuously or intermittently)

from 1945 to 1955
(Date) (Date)

4. Quantity of water claimed and used is 760 gallons per minute; _____ acre feet per year.

5. Purpose or Purposes for which water is used General Farming
Irrigation
(Domestic, irrigation, municipal, manufacturing, industrial, etc.)

6. Description of Well: Depth 45 feet. Type drilled
(Dug or drilled)
diameter: 1.0 inches. Elevation of ground at well site 100 feet feet, mean sea level.
(As near as known)

Depth to water table 8 feet. Flows in winter

7. Capacity of Well: 760 g.p.m. with 1 feet drawdown.
15 g.p.m. with _____ feet drawdown.

Date of test _____

If Flowing Well: Measured discharge _____ g.p.m. on _____
(Date)

Shut-in pressure at ground surface _____ lbs. per sq. in. on _____
(Date)

Water is controlled by _____
(Cap, valve, etc.)

8. Casing: (Give diameter, commercial specifications and depth below ground surface of each casing size.)

10' inch diameter *steel casing* from 0 to 27 feet
 inch diameter from to feet
 inch diameter from to feet
 inch diameter from to feet

Describe and show depth of shoe, plug, adapter, liner or other details:

9. Perforated Casings or Screens:

18 ft Perforated Pipe from 27 to 45
(Number per foot and size of perforations, or describe screen)
 from to
 from to
 from to

10. Log of Well: (Describe each stratum or formation clearly, indicate if water bearing, and give thickness and depth as indicated.)

MATERIAL	Thickness (Feet)	Depth to Bottom (Feet)
<i>memory log</i> <i>silt</i>	0	27
<i>gravel</i>	27	45'

If log of well is not available, give name and address of driller.

Wymore Well Drillers

11. Infiltration Trench: Covered or open

Dimensions: Length ft. Minimum depth ft. Maximum depth ft.

Bottom width ft. Discharge g.p.m. Date of test

12. Tunnel: Type of lining

Dimensions:
(Length, course, and cross sectional size)

Position of water bearing stratum with reference to portal of tunnel

Log of tunnel: (Preceding table for log of well may be used, if desired. Give footage from portal and character of materials, as pertinent.)

13. Pumping Equipment:

(a) Pump *Centrifugal 3"* Capacity *600* g.p.m.
(Make, type and size)


(b) Motor *40 HP*
(Type and horsepower)

14. Location of area irrigated or to be irrigated, or place of use if for purposes other than irrigation.

Township North or South	Range E. or W. of Willamette Meridian	Section	Forty-acre Tract	Number Acres To Be Irrigated	Date of Reclamation
<i>T55</i>	<i>2W</i>	<i>30</i>	<i>SW 1/4 of NW 1/4</i>	<i>6</i>	<i>1945</i>
"	"	"	<i>NW 1/4 of SW 1/4</i>	<i>29</i>	"
"	"	"	<i>NE 1/4 of SW 1/4</i>	<i>30</i>	"
"	"	"	<i>SE 1/4 of NW 1/4</i>	<i>10</i>	"
"	"	"	<i>SW 1/4 of NE 1/4</i>	<i>4</i>	"
"	"	"	<i>NW 1/4 of SE 1/4</i>	<i>30</i>	"
				<i>104</i>	

15. If the ground water supply is supplemental to an existing water supply, identification of any application for a permit, permit, certificate or adjudicated right to appropriate water made or held by the registrant.

Township 5S Range 2W W.M.
North

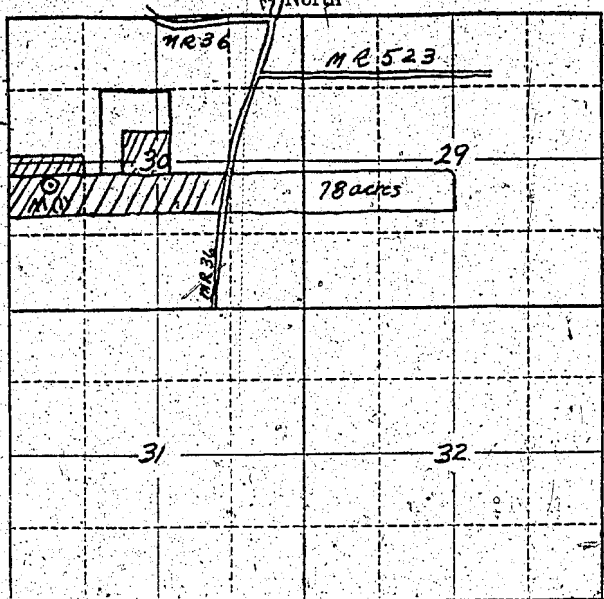

Locate well and acreage of irrigated land on plat.
Scale: 2" = 1 Mile

STATE OF OREGON }
County of _____ } ss.

I, Carter Keene, being first duly sworn, do hereby certify that I have read the foregoing Registration Statement and that all of the items therein contained are true to the best of my knowledge and belief.

Carter Keene
(Signature of Registrant)

Subscribed and sworn to before me this 16th day of February, 1956.

My commission expires _____
(Notary Public)

(SEAL)

CERTIFICATE OF REGISTRATION

STATE OF OREGON }
County of Marion } ss.

This is to certify that the foregoing Registration Statement was received in the office of the State Engineer on the 16th day of February, 1956, at 10:00 o'clock A. M. and has been duly recorded in said office in Book No. 1 of Registration Statements on page GR-107C.

~~Construction of the canal completed by _____ and the same completely applied to beneficial use by _____.~~

Witness my hand this 12th day of April, 1956.

Lewis A. Stanley
(State Engineer)

By _____
(Deputy)

GR-107 C