

RECEIVED

MAR 11 1958

Registration Statement

STATE ENGINEER

SALE OF CLAIM OF RIGHT TO APPROPRIATE GROUND WATER

TO THE STATE ENGINEER OF OREGON:

I, NICK ZAUNER

of Aurora County of MARION

State of ORE., do hereby make application for a certificate of registration as evidence of a right to appropriate ground water.

1. Source from which water is withdrawn is Well & Pump

(Flowing well, pump well, infiltration trench, or tunnel)

2. Location is: 3 mi SW Aurora (on Donald Road)

(Approximate distance and direction from nearest city or town)

and is more particularly described as follows:

(a) 740' S 470' E NW corner Sec 22

(Give distance and bearing to corner of section or other legal subdivision)

being within NW / NW of Sec. 22, Twp. 4S Rge. 1W

(Smallest legal subdivision)

(N. or S.)

(E. or W.)

or (b) within limits of recorded platted property, town or city:

in Lot \_\_\_\_\_, Block \_\_\_\_\_ of \_\_\_\_\_

(Name of plat or addition)

County of \_\_\_\_\_

(If within city or town, give name)

3. Construction Work was begun on OCT 19, 1951; was completed on 1951

(Date)

(Date)

and the ground water claimed was first used for the purposes set out below on Spring 1952

(Date)

since which time the water has been used Intermittently

(Continuously or Intermittently)

from 1952 to 1957

(Date)

(Date)

4. Quantity of water claimed and used is 200 gallons per minute; 75 acre feet per year.

5. Purpose or Purposes for which water is used IRRIGATION & DOMESTIC

(Domestic, irrigation, municipal, manufacturing, industrial, etc.)

6. Description of Well: Depth 117 feet. Type DRILLED

(Dug or drilled)

diameter 8 inches. Elevation of ground at well site 177 feet, mean sea level.

(As near as known)

Depth to water table 32 feet.

7. Capacity of Well: 200 g.p.m. with 68 feet drawdown.

\_\_\_\_\_ g.p.m. with \_\_\_\_\_ feet drawdown.

Date of test 1951

If Flowing Well: Measured discharge \_\_\_\_\_ g.p.m. on \_\_\_\_\_

(Date)

Shut-in pressure at ground surface \_\_\_\_\_ lbs. per sq. in. on \_\_\_\_\_

(Date)

Water is controlled by \_\_\_\_\_

(Cap, valve, etc.)

8. Casing: (Give diameter, commercial specifications and depth below ground surface of each casing size.)

8 inch diameter ..... from 0 to 117 feet  
 ..... inch diameter ..... from ..... to ..... feet  
 ..... inch diameter ..... from ..... to ..... feet  
 ..... inch diameter ..... from ..... to ..... feet

Describe and show depth, of shoe, plug, adapter, liner or other details: .....

9. Perforated Casings or Screens:

mill Knife 36 holes 2 1/8 2 Ag from 110 to 115  
(Number per foot and size of perforations, or describe screen)  
 ..... from ..... to .....  
 ..... from ..... to .....  
 ..... from ..... to .....

10. Log of Well: (Describe each stratum or formation clearly, indicate if water bearing, and give thickness and depth as indicated.)

MATERIAL	Thickness (Feet)	Depth to Bottom (Feet)
Surface	4	4
yellow clay	22	26
Surface Sand	3	29
Broken-sand-clay	44	73
Blue clay	11	84
Black Sand (water)	12	96
Broken Sand & Gravel	22	118

If log of well is not available, give name and address of driller. ....

11. Infiltration Trench: Covered or open .....

Dimensions: Length ..... ft. Minimum depth ..... ft. Maximum depth ..... ft.

Bottom width ..... ft. Discharge ..... g.p.m. Date of test .....

12. Tunnel: Type of lining .....

Dimensions: .....  
(Length, course, and cross sectional size)

Position of water bearing stratum with reference to portal of tunnel .....

Log of tunnel: (Preceding table for log of well may be used, if desired. Give footage from portal and character of materials, as pertinent.)

13. Pumping Equipment: -

(a) Pump Turbine ..... Capacity 200 g.p.m.  
(Make, type and size)


(b) Motor 15 HP Elec 3φ .....  
(Type and horsepower)

14. Location of area irrigated or to be irrigated, or place of use if for purposes other than irrigation.

Township North or South	Range E. or W. of Willamette Meridian	Section	Forty-acre Tract	Number Acres To Be Irrigated	Date of Reclamation
4S	1W	22	NW/NW	20	1952
"	"	22	SW/NW	10	1952
				30 Ac	"

15. If the ground water supply is supplemental to an existing water supply, identification of any application for a permit, permit, certificate or adjudicated right to appropriate water made or held by the registrant.

Township 45 Range 1W, W.M.  
North.

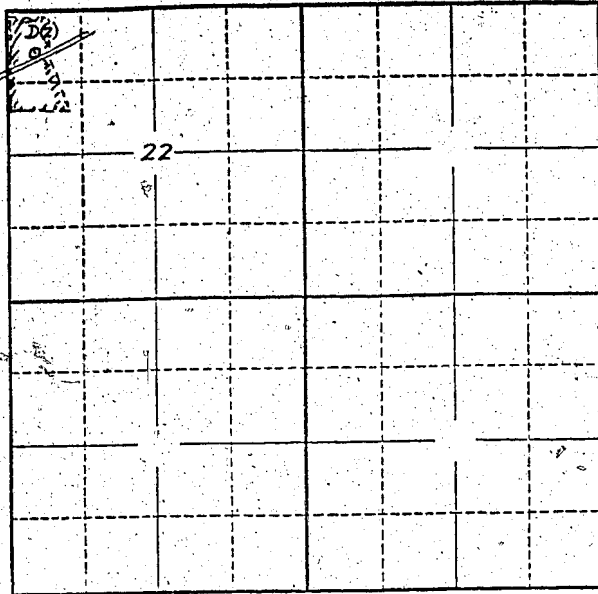

Locate well and acreage of irrigated land on plat.  
Scale: 2" = 1 Mile

STATE OF OREGON

County of Marion

} ss.

I, Nick Zanner, being first duly sworn, do hereby certify that I have read the foregoing Registration Statement and that all of the items therein contained are true to the best of my knowledge and belief.

Nick Zanner  
(Signature of Registrant)

Subscribed and sworn to before me this 20<sup>th</sup> day of February, 1958.

My commission expires Sept. 8, 1960

Albert [Signature]  
(Notary Public)

(SEAL)

**CERTIFICATE OF REGISTRATION**

STATE OF OREGON

County of Marion

} ss.

This is to certify that the foregoing Registration Statement was received in the office of the State Engineer on the 1 day of March, 1958, at \_\_\_\_\_ o'clock \_\_\_\_\_ M. and has been duly recorded in said office in Book No. 6 of Registration Statements on page GR-125

Witness my hand this 28 day of August, 1958.

Lewis A. Stanley  
(State Engineer)

By \_\_\_\_\_  
(Deputy)