REGISTRATION NO. GR-1168

Registration Statement

CERTIFICATE NO. GR-1129

OF CLAIMANT OF RIGHT TO APPROPRIATE GROUND WATER

(Under Chapter 708, Oregon Laws 1955.)

TO THE STATE ENGINEER OF OREGON:

I, Olive A. Saunler, of Stayton, Ore Box 101, County of Marion, State of Oregon, do hereby make application for a certificate of registration as evidence of a right to appropriate ground water.

1. **Source** from which water is withdrawn is Pump Well (Flowing well, pump well, infiltration trench, or tunnel)

2. **Location** is: One-half mile east of Stayton, Ore. (Approximate distance and direction from nearest city or town);

and is more particularly described as follows:

(a) 1510' E & 1699' S of 1/4 sec corner West side Sec 11 (Give distance and bearing to corner of section or other legal subdivision)

being within SE / SW (Smallest legal subdivision) of Sec. 11, Twp. 9 S (N. or S.), Rge. 1 (E. or W.)

or (b) within limits of recorded platted property, town or city: _____

in Lot _____, Block _____ of _____ (Name of plat or addition)

_____ (If within city or town, give name) County of _____

3. **Construction Work** was begun on June 9 1948 (Date); was completed on June [illegible] (Date)

and the ground water claimed was first used for the purposes set out below on June [illegible] (Date);

since which time the water has been used [illegible] intermittently (Continuously or intermittently)

from June (Date) to Sept (Date)

4. **Quantity** of water claimed and used is 40.0 gallons per minute; 20.0 acre feet per year.

5. **Purpose or Purposes** for which water is used Irrigation

_____ (Domestic, irrigation, municipal, manufacturing, industrial, etc.)

6. **Description of Well:** Depth 10 feet. Type drilled (Dug or drilled)

diameter 6 inches. Elevation of ground at well site 460 (As near as known) feet, mean sea level.

Depth to water table [illegible] feet.

7. **Capacity of Well:** _____ g.p.m. with Don't Know feet drawdown.

_____ g.p.m. with _____ feet drawdown.

Date of test _____

If Flowing Well: Measured discharge _____ g.p.m. on _____ (Date)

Shut-in pressure at ground surface _____ lbs. per sq. in. on _____ (Date)

Water is controlled by _____ (Cap, valve, etc.)

8. **Casing:** (Give diameter, commercial specifications and depth below ground surface of each casing size.)

6 inch diameter from top to 20 feet

inch diameter from to feet

inch diameter from to feet

inch diameter from to feet

Describe and show depth of shoe, plug, adapter, liner or other details:

9. **Perforated Casings or Screens:**

? from to

(Number per foot and size of perforations, or describe screen)

from to

from to

from to

10. **Log of Well:** (Describe each stratum or formation clearly, indicate if water bearing, and give thickness and depth as indicated.)

MATERIAL	Thickness (Feet)	Depth to Bottom (Feet)
soil	7'	7'
rock and coarse gravel	7'	14'
fine sand	6'	20'

GR-1129

If log of well is not available, give name and address of driller. Chas Hecht
Scs, Ore

11. **Infiltration Trench:** Covered or open .....

Dimensions: Length ..... ft. Minimum depth ..... ft. Maximum depth ..... ft.

Bottom width ..... ft. Discharge ..... g.p.m. Date of test .....

12. **Tunnel:** Type of lining .....

Dimensions: .....
(Length, course, and cross sectional size)

Position of water bearing stratum with reference to portal of tunnel .....

Log of tunnel: (Preceding table for log of well may be used, if desired. Give footage from portal and character of materials, as pertinent.)

13. **Pumping Equipment:**

(a) Pump Standard Elec. Model 350 Type CH Capacity 40 (Est.) g.p.m.
(Make, type and size)

(b) Motor [illegible] H.P.
(Type and horsepower)

14. Location of area irrigated or to be irrigated, or place of use if for purposes other than irrigation.

Township North or South	Range E. or W. of Willamette Meridian	Section	Forty-acre Tract	Number Acres To Be Irrigated	Date of Reclamation
~~0~~	~~I~~	~~II~~		~~I~~	
9S	1W	11	SW/SW	2.6	June 1952
"	"	"	SE/SW	5.5	" "
				8.1	

15. If the ground water supply is supplemental to an existing water supply, identification of any application for a permit, permit, certificate or adjudicated right to appropriate water made or held by the registrant.

.....

.....

GR-1129

Township 9 S Range 1 W, W.M.

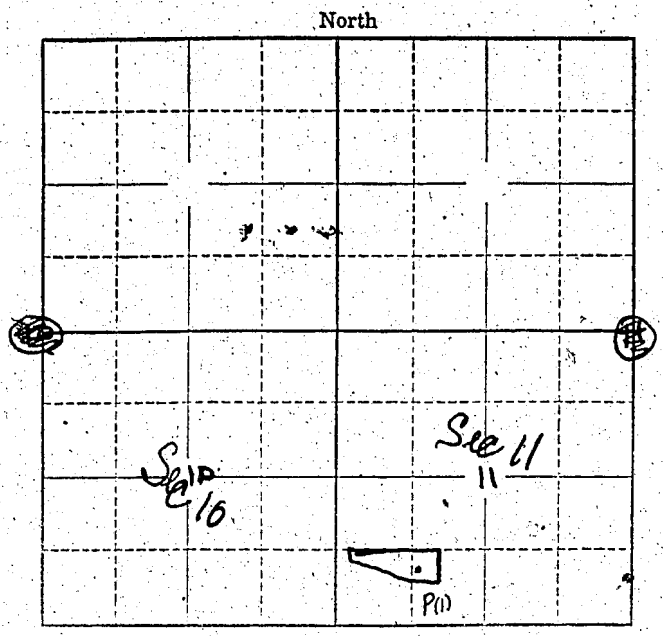

Locate well and acreage of irrigated land on plat.

Scale: 2" = 1 Mile

STATE OF OREGON
County of Marion } ss.

I, Olive A. Samples, being first duly sworn, do hereby certify that I have read the foregoing Registration Statement and that all of the items therein contained are true to the best of my knowledge and belief.

Olive A. Samples
(Signature of Registrant)

Subscribed and sworn to before me this 12th day of March, 1958

My commission expires 9/27/58 Jennie Baxter
(Notary Public)

(SEAL)

CERTIFICATE OF REGISTRATION

STATE OF OREGON
County of Marion } ss.

This is to certify that the foregoing Registration Statement was received in the office of the State Engineer on the 12 day of March, 1958, at 9.00 o'clock A M. and has been duly recorded in said office in Book No. 6 of Registration Statements on page GR-1129

~~Construction shall be completed by XXXXXXXXXXXXXXXXXXXX, 19XX and the water completely applied to beneficial use by XXXXXXXXXXXXXXXXXX, 19XXX~~

Witness my hand this 26 day of August, 1958

Lewis A. Stanley
(State Engineer)

$15.00

By
(Deputy)

GR-1129