REGISTRATION NO. GR-1169

Registration Statement

CERTIFICATE NO. GR-1130

OF CLAIMANT OF RIGHT TO APPROPRIATE GROUND WATER

(Under Chapter 708, Oregon Laws 1955.)

TO THE STATE ENGINEER OF OREGON:

I, Eddie & Hazel G. Fish,

of R 3 bx 780 Salem Ore. County of Marion

State of Oregon, do hereby make application for a certificate of registration as evidence of a right to appropriate ground water.

1. **Source** from which water is withdrawn is pump well
(Flowing well, pump well, infiltration trench, or tunnel)

2. **Location is:** 1 2m South
(Approximate distance and direction from nearest city or town);

and is more particularly described as follows:

(a) 1815 ft W 561 ft N from S¼ cor between Sec 5 & 8
(Give distance and bearing to corner of section or other legal subdivision)

being within S½ of SW¼ of Sec. 5, Twp. 9 S (N. or S.), Rge. 3 W (E. or W.) WM.
(Smallest legal subdivision)

or (b) within limits of recorded platted property, town or city:

in Lot ....., Block ..... of .....
(Name of plat or addition)

..... County of Marion.
(If within city or town, give name)

3. **Construction Work** was begun on Sept. 1943 (Date); was completed on Sept. 1943 (Date)

and the ground water claimed was first used for the purposes set out below on June 1944 (Date),

since which time the water has been used intermittently during season
(Continuously or intermittently)

from June 1944 (Date) to Oct. 1957 (Date)

4. **Quantity** of water claimed and used is 56 gallons per minute; 25 acre feet per year.

5. **Purpose or Purposes** for which water is used Irrigation
(Domestic, irrigation, municipal, manufacturing, industrial, etc.)

6. **Description of Well:** Depth 170 feet. Type drilled
(Dug or drilled)

diameter 6 inches. Elevation of ground at well site 196 (As near as known) feet, mean sea level.

Depth to water table 30 feet.

7. **Capacity of Well:** Unknown g.p.m. with ..... feet drawdown.

..... g.p.m. with ..... feet drawdown.

Date of test Not tested

If Flowing Well: Measured discharge ..... g.p.m. on ..... (Date)

Shut-in pressure at ground surface ..... lbs. per sq. in. on ..... (Date)

Water is controlled by .....
(Cap, valve, etc.)

8. **Casing:** (Give diameter, commercial specifications and depth below ground surface of each casing size.)

6 inch diameter steel casing from 0 to 78 feet

..... inch diameter ..... from ..... to ..... feet

..... inch diameter ..... from ..... to ..... feet

..... inch diameter ..... from ..... to ..... feet

Describe and show depth of shoe, plug, adapter, liner or other details: .....

9. **Perforated Casings or Screens:**

None from ..... to .....
(Number per foot and size of perforations, or describe screen)

..... from ..... to .....

..... from ..... to .....

..... from ..... to .....

10. **Log of Well:** (Describe each stratum or formation clearly, indicate if water bearing, and give thickness and depth as indicated.)

MATERIAL	Thickness (Feet)	Depth to Bottom (Feet)
Not known		0

GR-1130

If log of well is not available, give name and address of driller. H. E. Evans
Wheatland Road

11. **Infiltration Trench:** Covered or open .....

Dimensions: Length ..... ft. Minimum depth ..... ft. Maximum depth ..... ft.

Bottom width ..... ft. Discharge ..... g.p.m. Date of test .....

12. **Tunnel:** Type of lining .....

Dimensions: .....
(Length, course, and cross sectional size)

Position of water bearing stratum with reference to portal of tunnel .....

Log of tunnel: (Preceding table for log of well may be used, if desired. Give footage from portal and character of materials, as pertinent.)

13. **Pumping Equipment:**

(a) Pump Jacuzzi Jet (Make, type and size) Capacity 56 g.p.m.

(b) Motor 5 HP 1 ϕ 240 V. (Type and horsepower)

14. Location of area irrigated or to be irrigated, or place of use if for purposes other than irrigation.

Township North or South	Range E. or W. of Willamette Meridian	Section	Forty-acre Tract	Number Acres To Be Irrigated	Date of Reclamation
T. 9 S	3 W	5	S.W¼ S.W¼	11	June 1944

15. If the ground water supply is supplemental to an existing water supply, identification of any application for a permit, permit, certificate or adjudicated right to appropriate water made or held by the registrant.

.....

.....

GR-1130

Township 9S Range 3W, W.M.

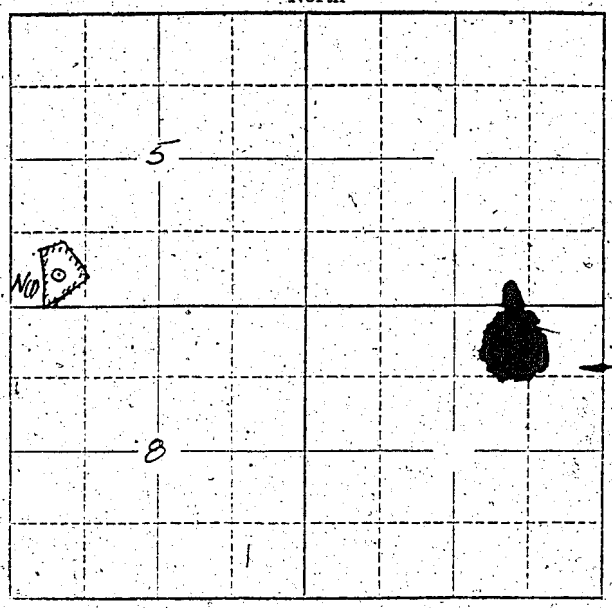

Locate well and acreage of irrigated land on plat.

Scale: 2" = 1 Mile

STATE OF OREGON
County of Marion } ss.

I, ~~Mrs Ed~~ Hazel G. Fish, being first duly sworn, do hereby certify that I have read the foregoing Registration Statement and that all of the items therein contained are true to the best of my knowledge and belief.

Hazel G. Fish
(Signature of Registrant)

Subscribed and sworn to before me this 12 day of March, 1958.

My commission expires 9/27/58

Lucie Gaytes
(Notary Public)

(SEAL)

CERTIFICATE OF REGISTRATION

STATE OF OREGON
County of Marion } ss.

This is to certify that the foregoing Registration Statement was received in the office of the State Engineer on the 12 day of March, 1958, at 10.00 o'clock A M. and has been duly recorded in said office in Book No. 6 of Registration Statements on page GR-1130

~~Construction should be completed by xxxxxxxxxxxxxxxxxxxxxx 19xxxx and the water completely applied to xxxxxxxxxxxxxxxxxxxxxxxxxxxxxx 19xxxx~~

Witness my hand this 28 day of August, 1958.

Lewis A. Stanley
(State Engineer)

By
(Deputy)

GR-1130