

Registration No. GR = 1172

Certificate No. GR = 1133

MAR 13 1958
STATE ENGINEER
SALEM, OREGON

Registration Statement

OF CLAIMANT OF RIGHT TO APPROPRIATE GROUND WATER

TO THE STATE ENGINEER OF OREGON:

I, J. W. & Minnie Vesek
of Jefferson County of Marion
State of Oregon, do hereby make application for a certificate of registration as evidence of a right to appropriate ground water.

1. Source from which water is withdrawn is Pump Well
(Flowing well, pump well, infiltration trench, or tunnel)

2. Location is: 1 1/2 Mi. South East of Jefferson
(Approximate distance and direction from nearest city or town)

and is more particularly described as follows:

(a) 322' W and 127' N from S.E. Corner Sec 12
(Give distance and bearing to corner of section or other legal subdivision)

being within SE/SE of Sec. 12, Twp. 10 S., Rge. 5
(Smallest legal subdivision) (N. or S.) (E. or W.)

or (b) within limits of recorded platted property, town or city:

in Lot , Block of
(Name of plat or addition)
County of
(If within city or town, give name)

3. Construction Work was begun on April 1954; was completed on
(Date) (Date)

and the ground water claimed was first used for the purposes set out below on Spring 1957
(Date)

since which time the water has been used Intermittently
(Continuously or Intermittently)

from to
(Date) (Date)

4. Quantity of water claimed and used is gallons per minute; 240 acre feet per year.

5. Purpose or Purposes for which water is used
(Domestic, irrigation, municipal, manufacturing, industrial, etc.)

6. Description of Well: Depth feet. Type
(Dug or drilled)

diameter inches. Elevation of ground at well site 240 feet, mean sea level.
(As near as known)

Depth to water table feet.

7. Capacity of Well: g.p.m. with feet drawdown.

 g.p.m. with feet drawdown.

Date of test During Test 1957

If Flowing Well: Measured discharge g.p.m. on
(Date)

Shut-in pressure at ground surface lbs. per sq. in. on
(Date)

Water is controlled by
(Cap, valve, etc.)

8. Casing: (Give diameter, commercial specifications and depth below ground surface of each casing size.)

10 inch diameter 0 from to 23 feet
 inch diameter from to feet
 inch diameter from to feet
 inch diameter from to feet

Describe and show depth of shoe, plug, adapter, liner or other details:

9. Perforated Casings or Screens:

Don't know from to
(Number per foot and size of perforations, or describe screen)
 from to
 from to
 from to

10. Log of Well: (Describe each stratum or formation clearly, indicate if water bearing, and give thickness and depth as indicated.)

MATERIAL	Thickness (Feet)	Depth to Bottom (Feet)
Soil	6	6
Don't know	6 - 14	14
Gravel	14 - 23	23

If log of well is not available, give name and address of driller. Bill Hamilton Albany Ore

11. Infiltration Trench: Covered or open

Dimensions: Length ft. Minimum depth ft. Maximum depth ft.

Bottom width ft. Discharge g.p.m. Date of test

12. Tunnel: Type of lining

Dimensions:
(Length, course, and cross sectional size)

Position of water bearing stratum with reference to portal of tunnel

Log of tunnel: (Preceding table for log of well may be used, if desired. Give footage from portal and character of materials, as pertinent.)

13. Pumping Equipment:

(a) Pump Centrifugal Pump 3x4 Capacity 300 g.p.m.
(Make, type and size)


(b) Motor Electric motor 2.5 H.P.
(Type and horsepower)

14. Location of area irrigated or to be irrigated, or place of use if for purposes other than irrigation.

Township North or South	Range E. or W. of Willamette Meridian	Section	Forty-acre Tract	Number Acres To Be Irrigated	Date of Reclamation
10 S	3 W	12	SE/NE	28.6	Spring 1955
"	"	"	NE/SE	36.7	" "
"	"	"	SE/SE	30.7	" "
				96.0 ac.	

15. If the ground water supply is supplemental to an existing water supply, identification of any application for a permit, permit, certificate or adjudicated right to appropriate water made or held by the registrant.

Township 10S Range 3W, W.M.
North

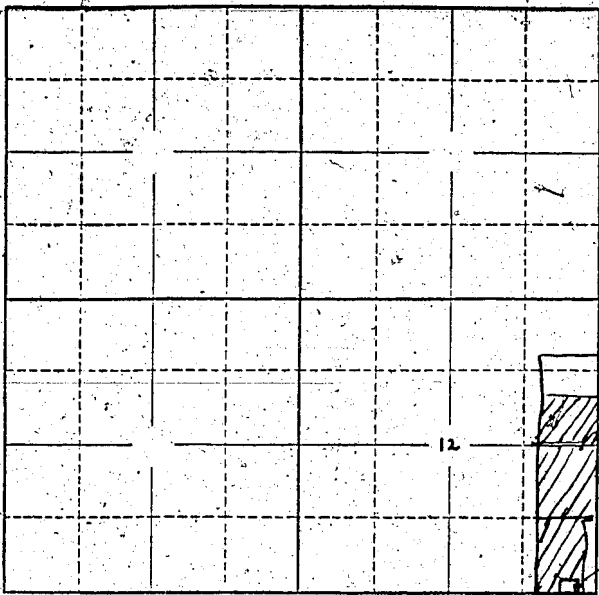

Locate well and acreage of irrigated land on plat.

Scale: 2" = 1 Mile

STATE OF OREGON

County of Marion } ss.

I, James Mack, being first duly sworn, do hereby certify that I have read the foregoing Registration Statement and that all of the items therein contained are true to the best of my knowledge and belief.

James Mack
(Signature of Registrant)

Subscribed and sworn to before me this 12 day of March, 1958

My commission expires

MY COMMISSION EXPIRES JULY 25, 1960.

Blayne Williams
(Notary Public)

(SEAL)

CERTIFICATE OF REGISTRATION

STATE OF OREGON

County of Marion } ss.

This is to certify that the foregoing Registration Statement was received in the office of the State Engineer on the 13 day of March, 1958, at 11:30 o'clock A.M. and has been duly recorded in said office in Book No. 6 of Registration Statements on page GR-1123.

Witness my hand this 20 day of August, 1958

Lawrence A. Stanley
(State Engineer)

By

(Deputy)

GR-1123