

RECEIVED  
MAR 13 1958  
STATE ENGINEER  
SALEM, OREGON

Registration No. GR. - 1173

Certificate No. GR. - 1134

# Registration Statement

## OF CLAIMANT OF RIGHT TO APPROPRIATE GROUND WATER

TO THE STATE ENGINEER OF OREGON:

I, E. O. KERRY  
of Jefferson County of Marion  
(Mailing address)  
State of Oregon, do hereby make application for a certificate of registration as evidence of a right to appropriate ground water.

- 1. Source from which water is withdrawn is Pump Well  
(Flowing well, pump well, infiltration trench, or tunnel)
- 2. Location is: 1/2 mi. South East of Jeff.  
(Approximate distance and direction from nearest city or town)

and is more particularly described as follows:

(a) 760' S and 680' E from N.W. Corner Sec 18  
(Give distance and bearing to corner of section or other legal subdivision)  
being within NW/ NW of Sec. 18, Twp. 18, Rge. 3  
(Smallest legal subdivision) (N. or S.) (E. or W.)

or (b) within limits of recorded platted property, town or city:  
in Lot \_\_\_\_\_, Block \_\_\_\_\_ of \_\_\_\_\_  
(Name of plat or addition)  
County of \_\_\_\_\_  
(If within city or town, give name)

3. Construction Work was begun on July 17, 1957; was completed on \_\_\_\_\_  
(Date) (Date)  
and the ground water claimed was first used for the purposes set out below on \_\_\_\_\_  
(Date)  
since which time the water has been used \_\_\_\_\_  
(Continuously or intermittently)  
from \_\_\_\_\_ to \_\_\_\_\_  
(Date) (Date)

4. Quantity of water claimed and used is \_\_\_\_\_ gallons per minute; 32 acre feet per year.

5. Purpose or Purposes for which water is used \_\_\_\_\_  
(Domestic, irrigation, municipal, manufacturing, industrial, etc.)

6. Description of Well: Depth \_\_\_\_\_ feet. Type \_\_\_\_\_  
(Dug or drilled)  
diameter \_\_\_\_\_ inches. Elevation of ground at well site 245 feet, mean sea level.  
(As near as known)  
Depth to water table \_\_\_\_\_ feet.

7. Capacity of Well: \_\_\_\_\_ g.p.m. with \_\_\_\_\_ feet drawdown.  
\_\_\_\_\_ g.p.m. with \_\_\_\_\_ feet drawdown.

Date of test During Test 1957

If Flowing Well: Measured discharge \_\_\_\_\_ g.p.m. on \_\_\_\_\_  
(Date)


Shut-in pressure at ground surface \_\_\_\_\_ lbs. per sq. in. on \_\_\_\_\_  
(Date)

Water is controlled by \_\_\_\_\_  
(Cap, valve, etc.)





Township 105 Range 2 W, W.M.  
North

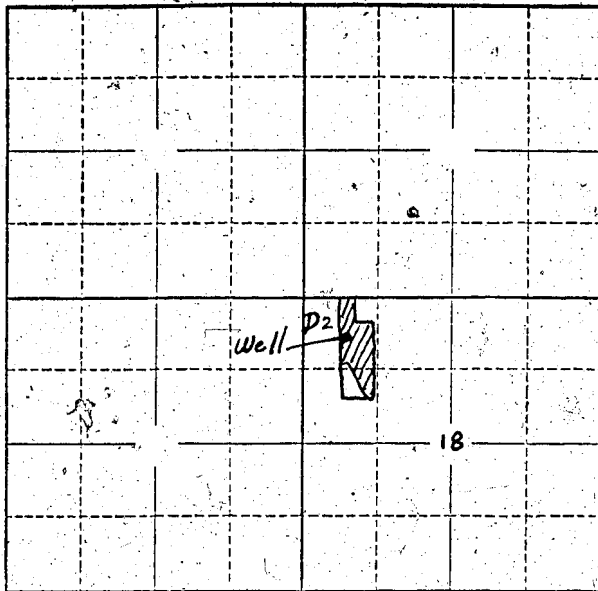

Locate well and acreage of irrigated land on plat.  
Scale: 2" = 1 Mile

STATE OF OREGON

County of Marion

} ss.

I, [Signature] being first duly sworn, do hereby certify that I have read the foregoing Registration Statement and that all of the items therein contained are true to the best of my knowledge and belief.

(Signature of Registrant)

Subscribed and sworn to before me this 11th day of August, 1958

My commission expires COMMISSION EXPIRES JULY 25, 1960

(Notary Public)

(SEAL)

**CERTIFICATE OF REGISTRATION**

STATE OF OREGON

County of Marion

} ss.

This is to certify that the foregoing Registration Statement was received in the office of the State Engineer on the 11 day of August, 1958, at 11 o'clock AM and has been duly recorded in said office in Book No. 6 of Registration Statements on page GR-1124

Witness my hand this 28 day of August, 1958

(State Engineer)

By

(Deputy)

GR-1124