

RECEIVED
MAR 13 1958
STATE ENGINEER
SALE, OREGON

Registration Statement

OF CLAIMANT OF RIGHT TO APPROPRIATE GROUND WATER

TO THE STATE ENGINEER OF OREGON:

I, S. Burton Ferguson
of Rt. 1, Box 207, Jefferson, Oregon County of Marion
(Mailing address)
State of Oregon, do hereby make application for a certificate of registration as evidence of a right to appropriate ground water:

- 1. Source from which water is withdrawn is pump well
(Flowing well, pump well, infiltration trench, or tunnel)
- 2. Location is: 1 mile south east of Jefferson
(Approximate distance and direction from nearest city or town)

and is more particularly described as follows:

(a) 515' East of S.W. Section corner 7 then 894' North
(Give distance and bearing to corner of section or other legal subdivision)
being within S.W. 1/4 of the S.W. 1/4 of Sec. 7 of Sec. 7, Twp. 10 S, Rge. 2 W
(Smallest legal subdivision) (E or S) (E or W)

or (b) within limits of recorded platted property, town or city:
in Lot _____, Block _____ of _____
(Name of plat or addition)
County of Marion
(If within city or town, give name)

3. Construction Work was begun on Sept. 1951; was completed on Sept. 1951
(Date) (Date)
and the ground water claimed was first used for the purposes set out below on June 1952
(Date)
since which time the water has been used intermittently
(Continuously or intermittently)
from June 1952 to September
(Date) (Date)

4. Quantity of water claimed and used is 460 gallons per minute; 80 acre feet per year.

5. Purpose or Purposes for which water is used irrigation
(Domestic, irrigation, municipal, manufacturing, industrial, etc.)

6. Description of Well: Depth 26 feet. Type drilled
(Dug or drilled)
diameter 10 inches. Elevation of ground at well site 250 feet; mean sea level.
(As near as known)
Depth to water table 65 feet.

7. Capacity of Well: _____ g.p.m. with _____ feet drawdown.
_____ g.p.m. with _____ feet drawdown.


Date of test _____

If Flowing Well: Measured discharge _____ g.p.m. on _____
(Date)

Shut-in pressure at ground surface _____ lbs. per sq. in. on _____
(Date)

Water is controlled by _____
(Cap, valve, etc.)

Township 10.5 Range 2.3W, W.M.
North

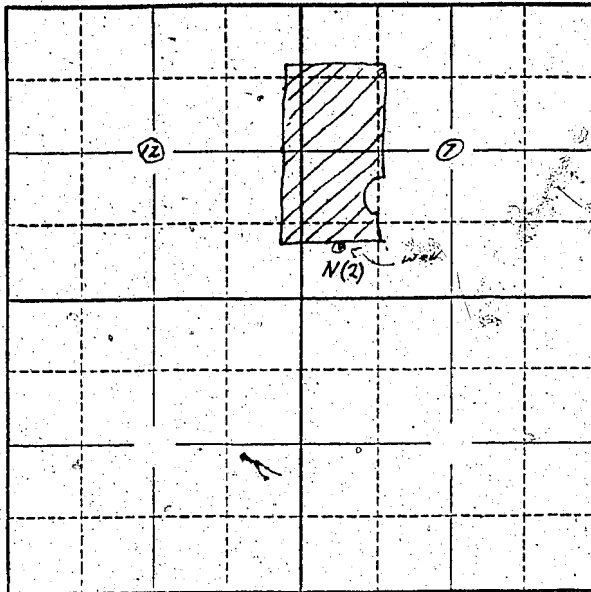

Locate well and acreage of irrigated land on plat.

Scale: 2" = 1 Mile

STATE OF OREGON

County of Marion } ss.

I, _____, being first duly sworn, do hereby certify that I have read the foregoing Registration Statement and that all of the items therein contained are true to the best of my knowledge and belief.

(Signature of Registrant)

Subscribed and sworn to before me this 14th day of March, 1958.

My commission expires _____
MY COMMISSION EXPIRES JULY 25, 1960.

(Notary Public)

(SEAL)

CERTIFICATE OF REGISTRATION

STATE OF OREGON }
County of Marion } ss.

This is to certify that the foregoing Registration Statement was received in the office of the State Engineer on the _____ day of _____, 19____, at _____ o'clock _____ M. and has been duly recorded in said office in Book No. 6 of Registration Statements on page GR-1135.

Witness my hand this 28 day of August, 1958

(State Engineer)

By _____
(Deputy)