REGISTRATION NO. GR-1177

CERTIFICATE NO. GR-1138

RECEIVED MAR 10 1958 STATE ENGINEER SALEM, OREGON

Registration Statement

OF CLAIMANT OF RIGHT TO APPROPRIATE GROUND WATER

(Under Chapter 708, Oregon Laws 1955.)

TO THE STATE ENGINEER OF OREGON:

I, Edwin F. Parent,

of Milton-Freewater, R.3 Bx.259. County of Umatilla

State of Oregon, do hereby make application for a certificate of registration as evidence of a right to appropriate ground water.

1. **Source** from which water is withdrawn is Pump well (Flowing well, pump well, infiltration trench, or tunnel)

2. **Location** is: 1,3/4 miles North from Milton-Freewater, Oregon. (Approximate distance and direction from nearest city or town);

and is more particularly described as follows:

(a) 657 ft. South from a point 100 ft. East from the Northwest cor., of the Southeast 1/4 of the Southwest 1/4 of Sec. 25, Tp. 6 N. R. 35 E. W.M. (Give distance and bearing to corner of section or other legal subdivision)

being within SE1/4 of the SW 1/4 (Smallest legal subdivision) of Sec. 25, Twp. 6 N. (N. or S.), Rge. 35 E. W.M. (E. or W.)

or (b) within limits of recorded platted property, town or city:

in Lot ....., Block ..... of ..... (Name of plat or addition)

..... (If within city or town, give name) County of Umatilla

3. **Construction Work** was begun on Feb. 1923 (Date); was completed on June 1923 (Date)

and the ground water claimed was first used for the purposes set out below on June 1923. (Date),

since which time the water has been used continuously (Continuously or intermittently)

from June 1923 (Date) to Jan 4 th. 1958. (Date)

4. **Quantity** of water claimed and used is 132 gallons per minute; ..... acre feet per year.

5. **Purpose or Purposes** for which water is used Domestic and Irrigation. (Domestic, irrigation, municipal, manufacturing, industrial, etc.)

6. **Description of Well:** Depth drilled 38 feet. Type Dug and drilled (Dug or drilled) Dug 40 ft. dug part 8'x5' diameter pipe 8 inches. Elevation of ground at well site 930 (Above mean sea level) feet, mean sea level. Depth to water table varies from 20 ft. to 40 ft. below ground surface. feet.

7. **Capacity of Well:** 200 g.p.m. with varies from 20' to 40' according to season feet drawdown.

..... g.p.m. with ..... feet drawdown.

Date of test general observation during 4 years of my ownership.

If Flowing Well: Measured discharge ..... g.p.m. on ..... (Date)

Shut-in pressure at ground surface ..... lbs. per sq. in. on ..... (Date)

Water is controlled by ..... (Cap, valve, etc.)

8. **Casing:** (Give diameter, commercial specifications and depth below ground surface of each casing size.)

8 inch diameter starts 36 ft from to 68 feet

inch diameter from to feet

inch diameter from to feet

inch diameter from to feet

Describe and show depth of shoe, plug, adapter, liner or other details:

This information not available

9. **Perforated Casings or Screens:**

(Number per foot and size of perforations, or describe screen) from to

from to

from to

from to

10. **Log of Well:** (Describe each stratum or formation clearly, indicate if water bearing, and give thickness and depth as indicated.)

MATERIAL	Thickness (Feet)	Depth to Bottom (Feet)
Log not available.		

GR-1128

If log of well is not available, give name and address of driller. Drillers not definitely known

11. **Infiltration Trench:** Covered or open .....

Dimensions: Length ..... ft. Minimum depth ..... ft. Maximum depth ..... ft.

Bottom width ..... ft. Discharge ..... g.p.m. Date of test .....

12. **Tunnel:** Type of lining .....

Dimensions: ..... (Length, course, and cross sectional size)

Position of water bearing stratum with reference to portal of tunnel .....

Log of tunnel: (Preceding table for log of well may be used, if desired. Give footage from portal and character of materials, as pertinent.)

13. **Pumping Equipment:**

(a) Pump Present pump 3 H.P. High head Pressure (Make, type and size) Capacity 133 g.p.m.

(b) Motor 3 H.P. Pacific pressure pump 3 phase (Type and horsepower) and 1/3 h.P. house pump also

14. Location of area irrigated or to be irrigated, or place of use if for purposes other than irrigation.

Township North or South	Range E. or W. of Willamette Meridian	Section	Forty-acre Tract	Number Acres To Be Irrigated	Date of Reclamation
6 N.	35 E.W.M.	25	SE 1/4 of SW 1/4	7.98	1923

15. If the ground water supply is supplemental to an existing water supply, identification of any application for a permit, permit, certificate or adjudicated right to appropriate water made or held by the registrant.

G-742 ck

GR-1128

Township 6 N Range 35 E, W.M.

North Sec. 25

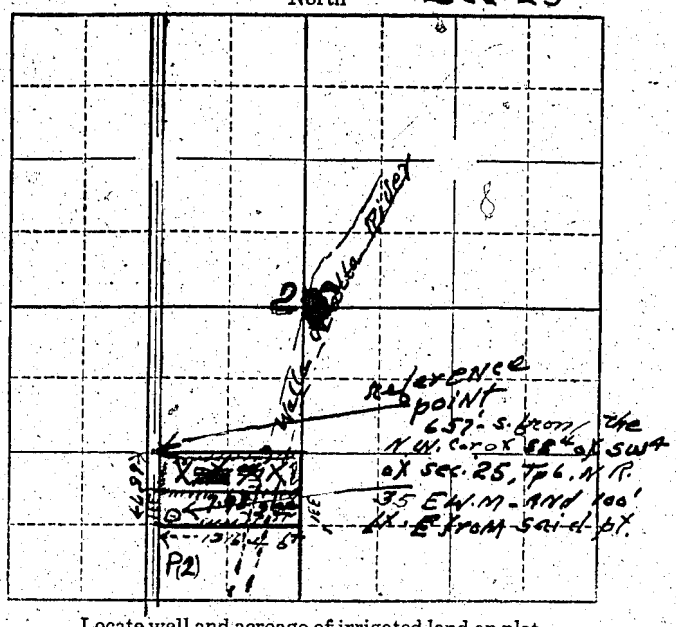

Locate well and acreage of irrigated land on plat.

Scale: 1 Mile

" 4" = 1M.

STATE OF OREGON
County of Umatilla } ss.

I, Edwin F. Parrott, being first duly sworn, do hereby certify that I have read the foregoing Registration Statement and that all of the items therein contained are true to the best of my knowledge and belief.

Edwin F. Parrott
(Signature of Registrant)

Subscribed and sworn to before me this 8 day of February, 1958

My commission expires 6/24/59

F. A. Fullerton
(Notary Public)
my Comm Exp. 6/24/59

(SEAL)

CERTIFICATE OF REGISTRATION

STATE OF OREGON
County of Marion } ss.

This is to certify that the foregoing Registration Statement was received in the office of the State Engineer on the ..... day of ....., 19....., at ..... o'clock ..... M. and has been duly recorded in said office in Book No. 6 of Registration Statements on page GR-11328

~~XXXX