

RECEIVED  
FEB 20 1956  
STATE ENGINEER  
SALEM, OREGON

REGISTRATION NO. GR-118  
CERTIFICATE NO. GR-109

### Registration Statement

#### OF CLAIMANT OF RIGHT TO APPROPRIATE GROUND WATER

(Under Chapter 708, Oregon Laws 1955.)

TO THE STATE ENGINEER OF OREGON:

I, R. G. and Eola L. Allen

of Rt. 1, Tangent County of Linn

State of Oregon, do hereby make application for a certificate of registration as evidence of a right to appropriate ground water.

- 1. Source from which water is withdrawn is pump well  
(Flowing well, pump well, infiltration trench, or tunnel)
- 2. Location is: 3 miles south of Albany, Oregon  
(Approximate distance and direction from nearest city or town)

and is more particularly described as follows:

(a) S. 12° 15' W. 3.75 chains from the SE corner of the Geo. H. Hughes DIC 78, T. 11 S., R. 4 W.  
(Give distance and bearing to corner of section or other legal subdivision)

being within SE 1/4 of NE 1/4 of Sec. 26, Twp. 11 S., Rge. 4 W.  
(Smallest legal subdivision) (N. or S.) (E. or W.)

or (b) within limits of recorded platted property, town or city:

in Lot \_\_\_\_\_, Block \_\_\_\_\_ of \_\_\_\_\_  
(Name of plat or addition)

County of Linn  
(If within city or town, give name)

3. Construction Work was begun on June 11, 1952; was completed on June 15, 1952  
(Date) (Date)

and the ground water claimed was first used for the purposes set out below on October 1, 1952  
(Date)

since which time the water has been used continuously  
(Continuously or intermittently)

from Oct. 1, 1952 to present time  
(Date) (Date)

4. Quantity of water claimed and used is 60 gallons per minute; 27.5 acre feet per year.

5. Purpose or Purposes for which water is used Irrigation

(Domestic, irrigation, municipal, manufacturing, industrial, etc.)

6. Description of Well: Depth 58 feet. Type drilled  
(Dug or drilled)

diameter 8 inches. Elevation of ground at well site 215 feet, mean sea level.  
(As near as known)

Depth to water table 16 feet.

7. Capacity of Well: 60 g.p.m. with 55 feet drawdown.

\_\_\_\_\_ g.p.m. with \_\_\_\_\_ feet drawdown.

Date of test Oct. 1, 1952

If Flowing Well: Measured discharge \_\_\_\_\_ g.p.m. on \_\_\_\_\_  
(Date)

Shut-in pressure at ground surface \_\_\_\_\_ lbs. per sq. in. on \_\_\_\_\_  
(Date)

Water is controlled by \_\_\_\_\_  
(Cap, valve, etc.)



If log of well is not available, give name and address of driller. T. J. Burkhart

169 N. 1st. W., Tremonton, Utah

11. Infiltration Trench: Covered or open .....

Dimensions: Length ..... ft. Minimum depth ..... ft. Maximum depth ..... ft.

Bottom width ..... ft. Discharge ..... g.p.m. Date of test .....

12. Tunnel: Type of lining .....

Dimensions: .....  
(Length, course, and cross sectional size)

Position of water bearing stratum with reference to portal of tunnel .....

Log of tunnel: (Preceding table for log of well may be used, if desired. Give footage from portal and character of materials, as pertinent.)

13. Pumping Equipment:

(a) Pump Fairbanks Morse deep well turbine Capacity 100 g.p.m.  
(Make, type and size)

(b) Motor 5 H. P. electric  
(Type and horsepower)

14. Location of area irrigated or to be irrigated, or place of use if for purposes other than irrigation.

Township North or South	Range E. or W. of Willamette Meridian	Section	Forty-acre Tract	Number Acres To Be Irrigated	Date of Reclamation
11 S	4 W.	26	SW $\frac{1}{4}$ of NE $\frac{1}{4}$	8.4	Oct. 1, 1952
11 S	4 W.	26	SE $\frac{1}{4}$ of NE $\frac{1}{4}$	2.6	" "
				11.0	

241-510


Beginning at the Northwest corner of the D.L.C. of Frances Simpson and wife Not. # 1317 Cl. #76 in T. 11 S., R. 4 W. of the Will. Mer. in Linn County, Oregon; and running thence East on the North boundary line of said D.L.C. 21.56 chains; thence South 23.19 chains; thence West 21.56 chains to the West boundary line of said D.L.C.; thence North 23.19 chains to the place of beginning containing 50 acres, more or less situated in Linn County, State of Oregon.

4-215

Beginning at the Southeast corner of the D.L.C. of G. H. Hughes and wife being Cl. # 78 in T. 11 S., R. 4 W. of the Will. Mer. in Linn County, Oregon; and running thence West 34 chains; thence South 10.50 chains to a stake; thence East 34 chains to a stake in the East line of the D.L.C. of Vincent Watson and wife Cl. #62 in said Township & Range; thence North 10.60 chains to the place of beginning containing 35.87 acres, more or less situated in Linn County, State of Oregon. EXCEPTING from the land above described 15.87 acres off the west end deeded to W.E. Hickman by deed dated 11-9-16 and described in Cert. of Title #946 issued by the Registrar of Titles in and for Linn County, Oregon.


15. If the ground water supply is supplemental to an existing water supply, identification of any application for a permit, permit, certificate or adjudicated right to appropriate water made or held by the registrant.

Township 11 S. Range 4 W. W.M.  
North

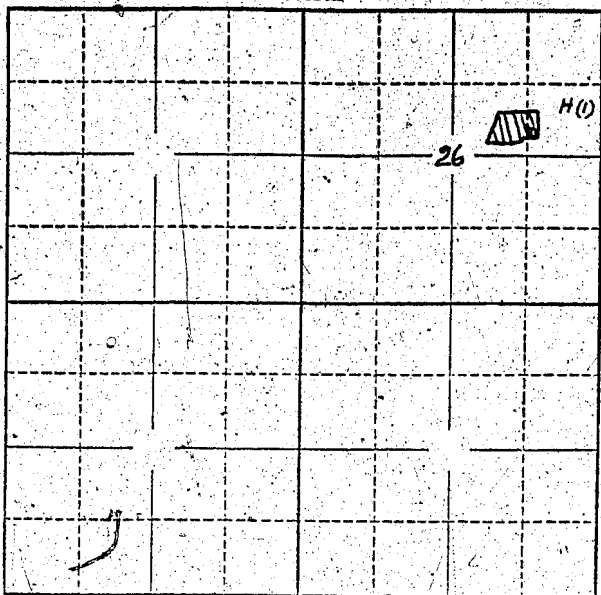

Locate well and acreage of irrigated land on plat.  
Scale: 2" = 1 Mile

STATE OF OREGON

County of Linn

ss.

I, R. G. and Eola L. Allen, being first duly sworn, do hereby certify that I have read the foregoing Registration Statement and that all of the items therein contained are true to the best of my knowledge and belief.

*R. G. Allen Eola L. Allen*  
(Signature of Registrant)

Subscribed and sworn to before me this 16th day of February, 1956.

My commission expires

*[Signature]*  
(Notary Public)

(SEAL)

CERTIFICATE OF REGISTRATION

STATE OF OREGON

County of Marion

ss.

This is to certify that the foregoing Registration Statement was received in the office of the State Engineer on the 20th day of February, 1956, at 1:00 o'clock A.M. and has been duly recorded in said office in Book No. 1 of Registration Statements on page GR-109C.

~~Construction shall be completed by \_\_\_\_\_ and the water capacity applied to~~

~~\_\_\_\_\_~~

Witness my hand this 12th day of April, 1956.

*Lewis A. Stanley*  
(State Engineer)

By \_\_\_\_\_ (Deputy)