

RECEIVED  
MAR 14 1958  
STATE ENGINEER  
SALEM, OREGON

Registration No. GR - 1181

Certificate No. GR - 1142

# Registration Statement

## OF CLAIMANT OF RIGHT TO APPROPRIATE GROUND WATER

TO THE STATE ENGINEER OF OREGON:

I, Opha D. Wilkinson

of Rt. 1 Box 117 Turner

(Mailing address)

County of Marion

State of Oregon do hereby make application for a certificate of registration as evidence of a right to appropriate ground water.

1. Source from which water is withdrawn is Pump Well

(Flowing well, pump well, infiltration trench, or tunnel)

2. Location is: 3/4 mile East of Marion

(Approximate distance and direction from nearest city or town)

and is more particularly described as follows:

(a) 162 ft. North E 85.8 ft. West from 1/4 corner on S line of Sec. 27, T9S, R2W

(Give distance and bearing to corner of section or other legal subdivision)

being within SE 1/4 of SW 1/4

(Smallest legal subdivision)

of Sec. 27

Twp. 9S

(N. or S.)

Rge. 2W

(E. or W.)

or (b) within limits of recorded platted property, town or city:

in Lot \_\_\_\_\_, Block \_\_\_\_\_ of \_\_\_\_\_

(Name of plat or addition)

County of \_\_\_\_\_

(If within city or town, give name)

3. Construction Work was begun on March 1951

(Date)

; was completed on Mar. 15, 1951

(Date)

and the ground water claimed was first used for the purposes set out below on 3/15/51

(Date)

since which time the water has been used intermittently

(Continuously or intermittently)

from 3/15/51 to present

(Date)

(Date)

4. Quantity of water claimed and used is 117 gallons per minute; 87.5 acre feet per year.

5. Purpose or Purposes for which water is used Irrigation

(Domestic, irrigation, municipal, manufacturing, industrial, etc.)

6. Description of Well: Depth 120 feet. Type Drilled

(Dug or drilled)

diameter 8 inches. Elevation of ground at well site 315 feet, mean sea level.

(As near as known)

Depth to water table 5 feet.

7. Capacity of Well: 117 g.p.m. with 100 feet drawdown.

\_\_\_\_\_ g.p.m. with \_\_\_\_\_ feet drawdown.

Date of test 3/15/51

If Flowing Well: Measured discharge \_\_\_\_\_ g.p.m. on \_\_\_\_\_

(Date)

Shut-in pressure at ground surface \_\_\_\_\_ lbs. per sq. in. on \_\_\_\_\_

(Date)


Water is controlled by \_\_\_\_\_

(Cap, valve, etc.)





Township 9S Range 2W W.M.  
North

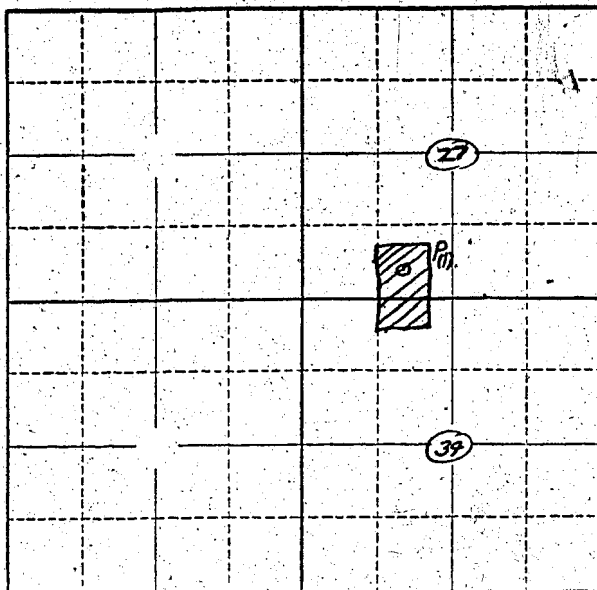

Locate well and acreage of irrigated land on plat.  
Scale: 2" = 1 Mile

STATE OF OREGON

County of Marion

} ss.

I, Alpha D. Wilkinson, being first duly sworn, do hereby certify that I have read the foregoing Registration Statement and that all of the items therein contained are true to the best of my knowledge and belief.

Alpha D. Wilkinson  
(Signature of Registrant)

Subscribed and sworn to before me this 13 day of March, 1953

My commission expires Nov 19-60

Allan J. Finchell  
(Notary Public)

(SEAL)

**CERTIFICATE OF REGISTRATION**

STATE OF OREGON

County of Marion

} ss.

This is to certify that the foregoing Registration Statement was received in the office of the State Engineer on the 14 day of March, 1953, at 8:00 o'clock A. M. and has been duly recorded in said office in Book No. 6 of Registration Statements on page GR-1142

Witness my hand this 28 day of August, 1958

Lewis A. Stanley  
(State Engineer)

By

(Deputy)

GR-1142