

RECEIVED
MAY 11 1958
STATE ENGINEER
SALEM, OREGON

REGISTRATION NO. GR-1182

Registration Statement CERTIFICATE NO. GR-1143

OF CLAIMANT OF RIGHT TO APPROPRIATE GROUND WATER

(Under Chapter 708, Oregon Laws 1955.)

TO THE STATE ENGINEER OF OREGON:

I, Floyd M. LaBar

of Rt 1, Harrisburg, County of Linn

State of Oregon, do hereby make application for a certificate of registration as evidence of a right to appropriate ground water.

1. Source from which water is withdrawn is Pump well
(Flowing well, pump well, infiltration trench, or tunnel)

2. Location is: Harrisburg, Oregon
(Approximate distance and direction from nearest city or town)

and is more particularly described as follows:

(a) 1390 feet west & 100 feet south from E 1/4 corner Section 15
(Give distance and bearing to corner of section or other legal subdivision)

being within NW 1/4 of SE 4 of Sec. 15, Twp. 16S, Rge. 4W
(Smallest legal subdivision) (N. or S.) (E. or W.)

or (b) within limits of recorded platted property, town or city: Harrisburg, Oregon

in Lot 12, Block - of Highview addition
(Name of plat or addition)

Harrisburg County of Linn
(If within city or town, give name)

3. Construction Work was begun on June 1953; was completed on June 1954
(Date) (Date)

and the ground water claimed was first used for the purposes set out below on June 1953
(Date)

since which time the water has been used Continuously
(Continuously or intermittently)

from June 1953 to date of this application
(Date) (Date)

4. Quantity of water claimed and used is 200 gallons per minute; 30 acre feet per year.

5. Purpose or Purposes for which water is used irrigation

(Domestic, irrigation, municipal, manufacturing, industrial, etc.)

6. Description of Well: Depth 30 feet. Type driven
two 2" iron pipes, 10' apart & together at pump (Dug or drilled)
diameter - inches. Elevation of ground at well site 340 feet, mean sea level.
(As near as known)

Depth to water table 8 feet.

7. Capacity of Well: 300 + g.p.m. with - feet drawdown. Estimate only
- g.p.m. with - feet drawdown.

Date of test No actual test made

If Flowing Well: Measured discharge - g.p.m. on - (Date)

Shut-in pressure at ground surface - lbs. per sq. in. on - (Date)

Water is controlled by -
(Cap, valve, etc.)

size.)

10

inch diameter

inch diameter

9. Perforated Casings or Screens:

18 inchs - with many fine perforations

(Number per foot and size of perforations, or describe screen)

from 18 to bottom

from to

from to

from to

ness and depth as indicated.)

Estimate that the last three feet is in water bearing sand and gravel.

If log of well is not available, give name and address of driller. _____

No log available - this is a driven well.

11. Infiltration Trench: Covered or open

Dimensions: Length ft. Minimum depth ft. Maximum depth ft.

Bottom width ft. Discharge g.p.m. Date of test

12. Tunnel: Type of lining

Dimensions: _____
(Length, course, and cross sectional size)

Position of water bearing stratum with reference to portal of tunnel

Log of tunnel: (Preceding table for log of well may be used, if desired. Give footage from portal and character of materials, as pertinent.)

13. Pumping Equipment:

(a) Pump Pacific 1 $\frac{1}{2}$ " X 1" (Plan to install larger pump) 50
Capacity g.p.m.
(Make, type and size)

(b) Motor Electric 3 hp. (Plan to install 7.5 hp pump)
(Type and horsepower)


14. Location of area irrigated or to be irrigated, or place of use if for purposes other than irrigation.

[illegible]

15. If the ground water supply is supplemental to an existing water supply, identification of any application for a permit, permit, certificate or adjudicated right to appropriate water made or held by the registrant.

GR 1143

Township 165 Range 4 W, W.M.
North

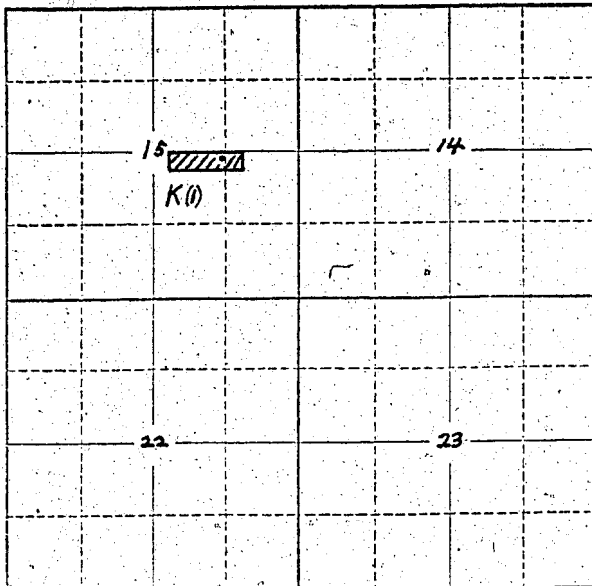

Locate well and acreage of irrigated land on plat.

Scale: 2" = 1 Mile

STATE OF OREGON

County of Linn

ss.

I, Floyd M. LaBar, being first duly sworn, do hereby certify that I have read the foregoing Registration Statement and that all of the items therein contained are true to the best of my knowledge and belief.

Floyd M. LaBar
(Signature of Registrant)

Subscribed and sworn to before me this 8th day of March, 19 58.

My commission expires August 13, 1958

Wm. W. Ladd
(Notary Public)

Notary Public for Oregon

(SEAL)

CERTIFICATE OF REGISTRATION

STATE OF OREGON

County of Marion

ss.

This is to certify that the foregoing Registration Statement was received in the office of the State Engineer on the 14 day of March, 19 58, at 8:00 o'clock A. M. and has been duly recorded in said office in Book No. 6 of Registration Statements on page GR-1113

Witness my hand this 28 day of August, 19 58.

Lew A. Stanley
(State Engineer)

By

(Deputy)

GR-1113