

RECEIVED
MAR 17 1958
STATE ENGINEER
SALEM

Registration Statement

CLAIMANT OF RIGHT TO APPROPRIATE GROUND WATER

TO THE STATE ENGINEER OF OREGON:

I, Michael Mack
of Aumsville County of Marion
State of OREGON, do hereby make application for a certificate of registration as evidence of a right to appropriate ground water.

1. Source from which water is withdrawn is Pump Well
(Flowing well, pump well, infiltration trench, or tunnel)

2. Location is: 1/2 mile East of West Stayton
(Approximate distance and direction from nearest city or town)

and is more particularly described as follows:

(a) 2079' N. & 264' E from 1/4 Corner on S. Line Sec 18
(Give distance and bearing to corner of section or other legal subdivision)

being within NW 1 SE of Sec. 18, Twp. 9S, Rge. 1W
(Smallest legal subdivision) (N. or S.) (E. or W.)

or (b) within limits of recorded platted property, town or city:

in Lot _____ Block _____ of _____
(Name of plat or addition)

County of _____
(If within city or town, give name)

3. Construction Work was begun on March 1954; was completed on March 1954
(Date) (Date)

and the ground water claimed was first used for the purposes set out below on April 1954
(Date)

since which time the water has been used intermittently
(Continuously or intermittently)

from May 1954 to September 1957
(Date) (Date)

4. Quantity of water claimed and used is 104 gallons per minute; 22.5 acre feet per year.

5. Purpose or Purposes for which water is used Irrigation

(Domestic, irrigation, municipal, manufacturing, industrial, etc.)

6. Description of Well: Depth 40 feet. Type Drilled
(Dug or drilled)

diameter 8 inches. Elevation of ground at well site _____ feet, mean sea level.
(As near as known)

Depth to water table 9 feet.

7. Capacity of Well: 300 g.p.m. with 10 feet drawdown.

_____ g.p.m. with _____ feet drawdown.


Date of test March 1954

If Flowing Well: Measured discharge _____ g.p.m. on _____
(Date)

Shut-in pressure at ground surface _____ lbs. per sq. in. on _____
(Date)

Water is controlled by _____
(Cap, valve, etc.)

Township 9S Range 1W, W.M.
North

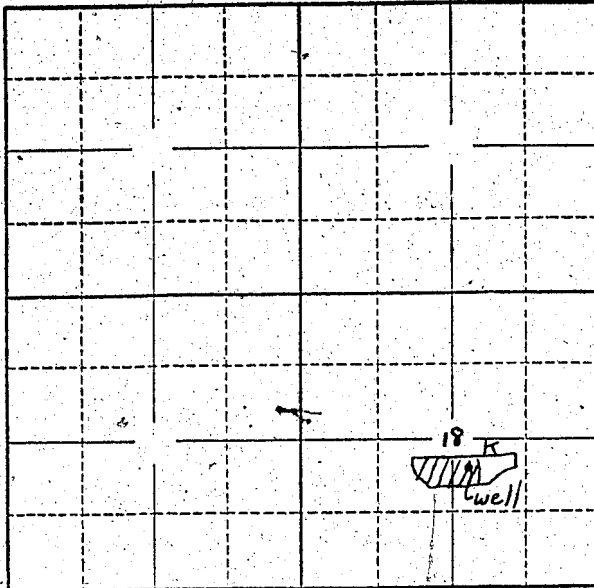

Locate well and acreage of irrigated land on plat.
Scale: 2" = 1 Mile

STATE OF OREGON

County of Marion } ss.

I, Michael Mack, being first duly sworn, do hereby certify that I have read the foregoing Registration Statement and that all of the items therein contained are true to the best of my knowledge and belief.

Michael Mack
(Signature of Registrant)

Subscribed and sworn to before me this 12 day of March, 1958.

My commission expires 8/21/58 Sharon R. Bess
(Notary Public)

(SEAL)

CERTIFICATE OF REGISTRATION

STATE OF OREGON

County of Marion } ss.

This is to certify that the foregoing Registration Statement was received in the office of the State Engineer on the 17 day of March, 1958, at 8:00 o'clock A. M. and has been duly recorded in said office in Book No. 6 of Registration Statements on page GR-1150

Witness my hand this 17 day of September, 1958

Lewis A. Stanley
(State Engineer)

By _____
(Deputy)