

\$15.00
State Engineer
Salem Oregon

RECEIVED
MAR 17 1958
STATE ENGINEER
SALEM, OREGON

Registration Statement

Registration No. GR - 1195
Certificate No. GR - 1156

OF CLAIMANT OF RIGHT TO APPROPRIATE GROUND WATER

TO THE STATE ENGINEER OF OREGON:

I, Arthur L. Baker
of 920 River Loop Eugene County of Lane
State of Oregon, do hereby make application for a certificate of registration as evidence of a right to appropriate ground water.

- Source from which water is withdrawn is Pump well
(Flowing well, pump well, infiltration trench, or tunnel)
- Location is: 3 miles N.E. of Santa Clara, Ore.
(Approximate distance and direction from nearest city or town)

and is more particularly described as follows:

(a) 355 chains N. & 310 chains E from SW corner section 1
(Give distance and bearing to corner of section or other legal subdivision)
being within NE 1/4 SW 1/4 of Sec. 1, Twp. 17S, Rge. 4W
(Smallest legal subdivision) (N. or S.) (E. or W.)

or (b) within limits of recorded platted property, town or city: _____
in Lot _____, Block _____ of _____
(Name of plat or addition)
County of _____
(If within city or town, give name)

3. Construction Work was begun on 1930; was completed on 1930
(Date) (Date)
and the ground water claimed was first used for the purposes set out below on 1930
(Date)
since which time the water has been used Continuously
(Continuously or Intermittently)
from May to Sept
(Date) (Date)

4. Quantity of water claimed and used is 50 gallons per minute; 10 acre feet per year.

5. Purpose or Purposes for which water is used irrigation
(Domestic, irrigation, municipal, manufacturing, industrial, etc.)

6. Description of Well: Depth 22 feet. Type drilled
(Dug or drilled)
diameter 3 inches. Elevation of ground at well site 308 ± feet, mean sea level.
(As near as known)
Depth to water table 8 feet.

7. Capacity of Well: _____ g.p.m. with _____ feet drawdown.
_____ g.p.m. with _____ feet drawdown.


Date of test not tested

If Flowing Well: Measured discharge _____ g.p.m. on _____
(Date)

Shut-in pressure at ground surface _____ lbs. per sq. in. on _____
(Date)

Water is controlled by _____
(Cap, valve, etc.)

Township 17S Range 4W, W.M.
North

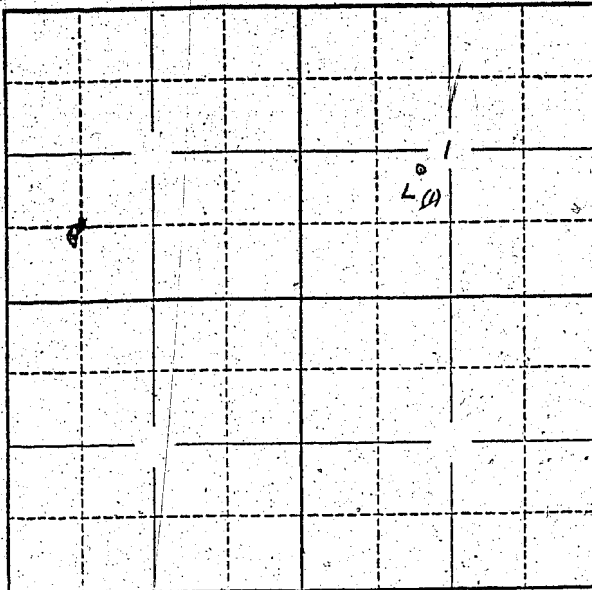

Locate well and acreage of irrigated land on plat.
Scale: 2" = 1 Mile

STATE OF OREGON

County of Lane

ss.

I, AL BAKER, being first duly sworn, do hereby certify that I have read the foregoing Registration Statement and that all of the items therein contained are true to the best of my knowledge and belief.

Al Baker

(Signature of Registrant)

Subscribed and sworn to before me this 14th day of March, 1958.

My commission expires June 25, 1961

Paul J. Hansen

(Notary Public)

(SEAL)

CERTIFICATE OF REGISTRATION

STATE OF OREGON

County of Marion

ss.

This is to certify that the foregoing Registration Statement was received in the office of the State Engineer on the 17 day of March, 1958, at 8:00 o'clock A. M. and has been duly recorded in said office in Book No. 6 of Registration Statements on page GR-1156

Witness my hand this 17 day of September, 1958

Lewis A. Stanley

(State Engineer)

By

(Deputy)

GR-1156