

Registration Statement

OF CLAIMANT OF RIGHT TO APPROPRIATE GROUND WATER

(Under Chapter 708, Oregon Laws 1955.)

TO THE STATE ENGINEER OF OREGON:

I, R. C. TAYLOR, Mayor

of Brownsville County of Linn

State of Oregon, do hereby make application for a certificate of registration as evidence of a right to appropriate ground water.

1. Source from which water is withdrawn is Pump Well
(Flowing well, pump well, infiltration trench, or tunnel)

2. Location is: City of Brownsville
(Approximate distance and direction from nearest city or town)

and is more particularly described as follows: Beginning at the intersection of the center line of Main Street and the North line of James Blakely DLC. No. 59; thence N. 89 degrees 13' 30" E 44.5 feet; thence N. 26 degrees 35' W. 90 feet to center of well.
(Give distance and bearing to corner of section or other legal subdivision)

being within SE 1/4 of SW 1/4 of Sec. 31 Twp. 13 S Rge. 2 W
(Smallest legal subdivision) (S. or S.) (E. or W.)

or (b) within limits of recorded platted property, town or city: Brownsville

in Lot _____, Block _____ of _____
(Name of plat or addition)

Brownsville County of Linn
(If within city or town, give name)

3. Construction Work was begun on 1921, was completed on 1921
(Date) (Date)

and the ground water claimed was first used for the purposes set out below on 1921
(Date)

since which time the water has been used Continuously
(Continuously or intermittently)

from 1921 to date hereof
(Date) (Date)

4. Quantity of water claimed and used is 225 gallons per minute; _____ acre feet per year.

5. Purpose or Purposes for which water is used Municipal water source for City of Brownsville
(Domestic, irrigation, municipal, manufacturing, industrial, etc.)

6. Description of Well: Depth 24 feet. Type Dug
(Dug or drilled)
diameter 86 1/2 inches. Elevation of ground at well site 305 feet, mean sea level.
(As near as known)
Depth to water table 18 feet.

7. Capacity of Well: 500 g.p.m. with 2 feet drawdown.
_____ g.p.m. with _____ feet drawdown.

Date of test 1951


If Flowing Well: Measured discharge _____ g.p.m. on _____
(Date)

Shut-in pressure at ground surface _____ lbs. per sq. in. on _____
(Date)

Water is controlled by Valve
(Cap, valve, etc.)

See attached survey.....

Township 15 S. Range 2W, W.M.
North

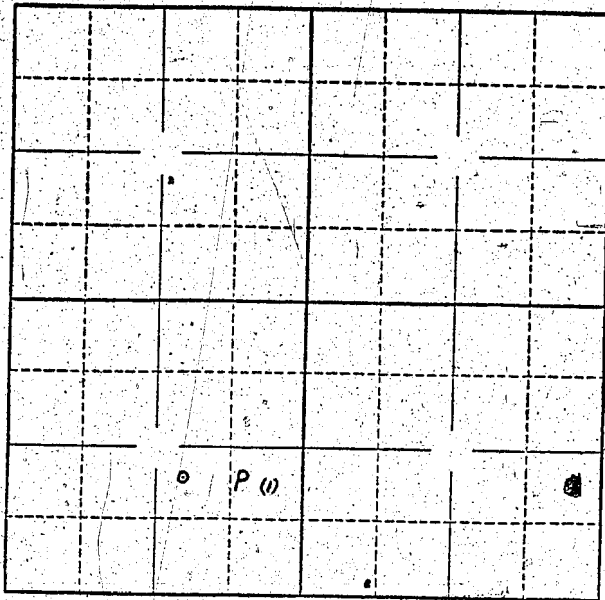

Locate well and acreage of irrigated land on plat.

Scale: $\frac{3}{4}$ " = 1 Mile

STATE OF OREGON

County of Linn

} ss.

I, R. C. Taylor, being first duly sworn, do hereby certify that I have read the foregoing Registration Statement and that all of the items therein contained are true to the best of my knowledge and belief.

R. C. Taylor
Mayor of ~~City of~~ City of Brownsville

Subscribed and sworn to before me this 15th day of September, 1955.

My commission expires May 25, 1956

Merle A. Long
(Notary Public)

(SEAL)

CERTIFICATE OF REGISTRATION

STATE OF OREGON

County of Marion

} ss.

This is to certify that the foregoing Registration Statement was received in the office of the State Engineer on the 19th day of September, 1955, at 8:00 o'clock A. M. and has been duly recorded in said office in Book No. 1 of Registration Statements on page 11.

Construction shall be completed by _____, 19____, and the water completely applied to beneficial use by _____, 19____.

Witness my hand this 24th day of February, 1956.

Lewis A. Stanley
(State Engineer)

By _____
(Deputy)