

Registration Statement

OF CLAIMANT OF RIGHT TO APPROPRIATE GROUND WATER

(Under Chapter 708, Oregon Laws 1955.)

TO THE STATE ENGINEER OF OREGON:

I, Louie W. Magee
 of Rt. 1, Box 145 Dayton County of Yamhill
 State of Oregon, do hereby make application for a certificate of registration as evidence
 of a right to appropriate ground water.

1. Source from which water is withdrawn is Pump Well
(Flowing well, pump well, infiltration trench, or tunnel)

2. Location is: 7 miles south of Dayton
(Approximate distance and direction from nearest city or town)

and is more particularly described as follows:

(a) 22.55 feet S 66° E of NW corner of section 21
(Give distance and bearing to corner of section or other legal subdivision)

being within NE 1/4 of NW 1/4 of Sec. 21, Twp. 55, Rge. 3W
(Smallest legal subdivision) (N. or S.) (E. or W.)

or (b) within limits of recorded platted property, town or city:

in Lot _____, Block _____ of _____
(Name of plat or addition)

County of _____
(If within city or town, give name)

3. Construction Work was begun on May 7, 1949; was completed on May 14, 1949
(Date) (Date)

and the ground water claimed was first used for the purposes set out below on June 20, 1949
(Date)

since which time the water has been used Intermittently
(Continuously or intermittently)

from June 20, 1949 to Feb. 21, 1956
(Date) (Date)

4. Quantity of water claimed and used is 250 gallons per minute; _____ acre
 feet per year.

5. Purpose or Purposes for which water is used Irrigation

(Domestic, irrigation, municipal, manufacturing, industrial, etc.)

6. Description of Well: Depth 234 feet. Type Drilled
(Dug or drilled)

diameter 8 inches. Elevation of ground at well site 160 feet, mean sea level.
(As near as known)

Depth to water table 25 feet.

7. Capacity of Well: 250 g.p.m. with 40 feet drawdown. 4 to 5 days pumping

_____ g.p.m. with _____ feet drawdown.

Date of test May 1949

If Flowing Well: Measured discharge _____ g.p.m. on _____
(Date)

Shut-in pressure at ground surface _____ lbs. per sq. in. on _____
(Date)

Water is controlled by _____
(Cap, valve, etc.)

If log of well is not available, give name and address of driller. Fred Wymore

11. Infiltration Trench: Covered or open
 Dimensions: Length ft. Minimum depth ft. Maximum depth ft.
 Bottom width ft. Discharge g.p.m. Date of test

12. Tunnel: Type of lining
 Dimensions:
(Length, course, and cross sectional size)
 Position of water bearing stratum with reference to portal of tunnel

Log of tunnel: (Preceding table for log of well may be used, if desired. Give footage from portal and character of materials, as pertinent.)


13. Pumping Equipment:
 (a) Pump Peerless Turbine Capacity 300 g.p.m.
(Make, type and size)
 (b) Motor GE. 15 HP.
(Type and horsepower)

14. Location of area irrigated or to be irrigated, or place of use if for purposes other than irrigation.

Township North or South	Range E. or W. of Willamette Meridian	Section	Forty-acre Tract	Number Acres To Be Irrigated	Date of Reclamation
<u>T5S</u>	<u>R3W</u>	<u>21</u>	<u>NW¹/₄ of NW¹/₄</u>	<u>38</u>	<u>6/20/49</u>
"	"	"	<u>SW¹/₄ of NW¹/₄</u>	<u>10</u>	"
"	"	"	<u>NE¹/₄ of NW¹/₄</u>	<u>27</u>	"
"	"	"	<u>SE¹/₄ of NW¹/₄</u>	<u>6</u>	"
"	"	"	<u>NW¹/₄ of NE¹/₄</u>	<u>2</u>	"

15. If the ground water supply is supplemental to an existing water supply, identification of any application for a permit, permit, certificate or adjudicated right to appropriate water made or held by the registrant.

Township 5 S Range 3 W W.M.
North

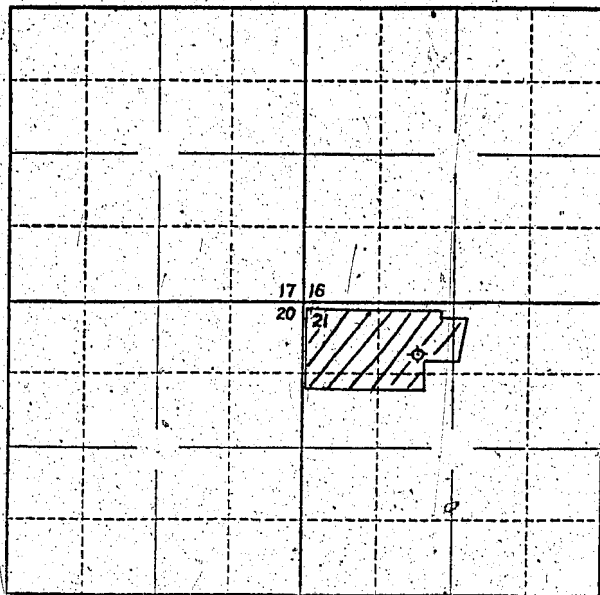

Locate well and acreage of irrigated land on plat.
Scale: 2" = 1 Mile

STATE OF OREGON

County of _____ } ss.

I, Louie W. Magee, being first duly sworn, do hereby certify that I have read the foregoing Registration Statement and that all of the items therein contained are true to the best of my knowledge and belief.

Louie W. Magee
(Signature of Registrant)

Subscribed and sworn to before me this 21st day of February, 1956.

My commission expires _____
(Notary Public)

(SEAL)

CERTIFICATE OF REGISTRATION

STATE OF OREGON

County of Marion } ss.

This is to certify that the foregoing Registration Statement was received in the office of the State Engineer on the 21st day of February, 1956, at 3:00 o'clock P.M. and has been duly recorded in said office in Book No. 1 of Registration Statements on page GR-111C.

~~Copies of this shall be furnished by _____ and the cost completely applied to _____
for its use by _____~~

Witness my hand this 12th day of April, 1956.

Lewis A. Stanley
(State Engineer)

By _____
(Deputy)

GR-111 C