

Registration Statement

OF CLAIMANT OF RIGHT TO APPROPRIATE GROUND WATER

TO THE STATE ENGINEER OF OREGON:

I, William A. & Nina E. Brown

of Route 1, Box 401; Aurora, Oregon County of Marion

(Mailing address)

State of Oregon do hereby make application for a certificate of registration as evidence of a right to appropriate ground water.

1. Source from which water is withdrawn is pump well
(Flowing well, pump well, infiltration trench, or tunnel)

2. Location is: approximately 1/2 mile south of Broadacres, Oregon
(Approximate distance and direction from nearest city or town)

and is more particularly described as follows:

(a) S 17° 33' E 320' from the NW corner of Section 36 T4S R2W
(Give distance and bearing to corner of section or other legal subdivision)

being within NE 1/4 NE 1/4 of Sec. 36, Twp. 4S, Rge. 2W
(Smallest legal subdivision) (N. or S.) (E. or W.)

or (b) within limits of recorded platted property, town or city: ----

in Lot ---, Block -- of ---
(Name of plat or addition)

--- County of ---

(If within city or town, give name)

3. Construction Work was begun on 7/13/55; was completed on 8/4/55
(Date) (Date)

and the ground water claimed was first used for the purposes set out below on 8/4/55
(Date)

since which time the water has been used Continuously for domestic and intermittently for irrigation
(Continuously or intermittently)

from 8/4/55 to 3/7/58
(Date) (Date)

4. Quantity of water claimed and used is 500 gallons per minute; 167 acre feet per year.

5. Purpose or Purposes for which water is used domestic and irrigation

(Domestic, irrigation, municipal, manufacturing, industrial, etc.)

6. Description of Well: Depth 164 feet. Type drilled

(Dug or drilled)

diameter 12 inches. Elevation of ground at well site 178 feet, mean sea level.
(As near as known)

Depth to water table 20 feet.

7. Capacity of Well: 500 g.p.m. with 30 feet drawdown.

--- g.p.m. with --- feet drawdown.

Date of test 8/4/55

If Flowing Well: Measured discharge --- g.p.m. on ---
(Date)

Shut-in pressure at ground surface --- lbs. per sq. in. on ---
(Date)

Water is controlled by ---
(Cap, valve, etc.)

8. Casing: (Give diameter, commercial specifications and depth below ground surface of each casing size.)

12 inch diameter Steel Casing from 0 to 147.5 feet
inch diameter from to feet
inch diameter from to feet
inch diameter from to feet

Describe and show depth of shoe, plug, adapter, liner or other details: None

9. Perforated Casings or Screens:

None from to
(Number per foot and size of perforations, or describe screen)
from to
from to
from to

10. Log of Well: (Describe each stratum or formation clearly, indicate if water bearing, and give thickness and depth as indicated.)

MATERIAL	Thickness (Feet)	Depth to Bottom (Feet)
Top Soil	3	3
Brown Silt & Clay	25	28
Blue Shale	69	97
Sand pan (water)	2	99
Blue Shale	49	150
Hard Blue Shale	3	153
Blue Shale	9	162
Sand (Black) Water	2	164

If log of well is not available, give name and address of driller. Willamette Drilling Company

Route 2, Box 333, Salem, Oregon

11. Infiltration Trench: Covered or open _____
 Dimensions: Length _____ ft. Minimum depth _____ ft. Maximum depth _____ ft.

Bottom width _____ ft. Discharge _____ g.p.m. Date of test _____

12. Tunnel: Type of lining _____

Dimensions: _____
 (Length, course, and cross sectional size)

Position of water bearing stratum with reference to portal of tunnel _____

Log of tunnel: (Preceding table for log of well may be used, if desired. Give footage from portal and character of materials, as pertinent.)

13. Pumping Equipment:

(a) Pump Poyomona _____ Capacity 120 g.p.m.
 (Make, type and size)


(b) Motor 7.5 Horsepower (electric) _____
 (Type and horsepower)

14. Location of area irrigated or to be irrigated, or place of use if for purposes other than irrigation.

Township North or South	Range E. or W. of Willamette Meridian	Section	Forty-acre Tract	Number Acres To Be Irrigated	Date of Reclamation
4S	2W	36	NE $\frac{1}{4}$ NE $\frac{1}{4}$ A	5.337	1958
"	"	"	NE $\frac{1}{4}$ NE $\frac{1}{4}$	0.158	1955
"	"	"	SE $\frac{1}{4}$ NE $\frac{1}{4}$	4.111	1955
4S	1W	31	NW $\frac{1}{4}$ NW $\frac{1}{4}$	26.547	1955
"	"	"	SW $\frac{1}{4}$ NW $\frac{1}{4}$	12.831	1955
"	"	"	NE $\frac{1}{4}$ NW $\frac{1}{4}$	3.450	1955
"	"	"	SE $\frac{1}{4}$ NW $\frac{1}{4}$	5.850	1955
				67.284	

15. If the ground water supply is supplemental to an existing water supply, identification of any application for a permit, permit, certificate or adjudicated right to appropriate water made or held by the registrant.

Township 4S Range 2W, W.M.
North

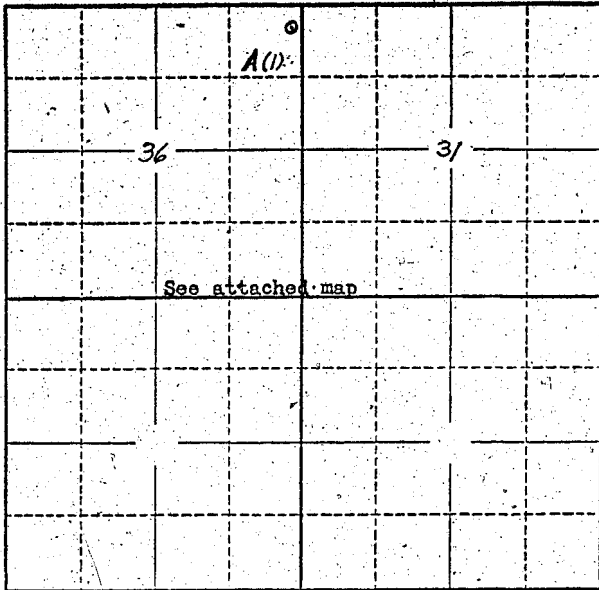

Locate well and acreage of irrigated land on plat.
Scale: 2" = 1 Mile

STATE OF OREGON

County of Marion } ss.

I, William A. Brown, being first duly sworn, do hereby certify that I have read the foregoing Registration Statement and that all of the items therein contained are true to the best of my knowledge and belief.

William A. Brown
(Signature of Registrant)

Subscribed and sworn to before me this 17 day of March, 1958.

My commission expires 9/27/58

Jeanie Baxter
(Notary Public)

(SEAL)

CERTIFICATE OF REGISTRATION

STATE OF OREGON

County of Marion } ss.

This is to certify that the foregoing Registration Statement was received in the office of the State Engineer on the 17 day of March, 1958, at 10²⁰ o'clock A.M. and has been duly recorded in said office in Book No. 6 of Registration Statements on page OR-1161

Witness my hand this 17 day of September, 1958

Lewis A. Stanley
(State Engineer)

By _____
(Deputy)

20²⁰