

Registration Statement

OF CLAIMANT OF RIGHT TO APPROPRIATE GROUND WATER

TO THE STATE ENGINEER OF OREGON:

I, William A. & Nina E. Brown
of Route 1, Box 401, Aurora, Oregon County of Marion
(Mailing address)

State of Oregon, do hereby make application for a certificate of registration as evidence of a right to appropriate ground water.

1. Source from which water is withdrawn is pump well
(Flowing well, pump well, infiltration trench, or tunnel)

2. Location is: approximately 2 mile southwesterly from Broadacres, Oregon
(Approximate distance and direction from nearest city or town)

and is more particularly described as follows:

(a) South 35° East 1950 feet from the Northwest corner of Section 36 T. 4S R2W
(Give distance and bearing to corner of section or other legal subdivision)
being within SW 1/4 of the NW 1/4 of Sec. 36, Twp. 4S, Rge. 2W
(Smallest legal subdivision) (N. or S.) (E. or W.)

or (b) within limits of recorded platted property, town or city: ---
in Lot ---, Block --- of ---
(Name of plat or addition)

--- County of ---
(If within city or town, give name)

3. Construction Work was begun on 5-1947; was completed on 7-1947
(Date) (Date)

and the ground water claimed was first used for the purposes set out below on 7-1947
(Date)

since which time the water has been used intermittently
(Continuously or Intermittently)

from 7-1947 to 3-1958
(Date) (Date)

4. Quantity of water claimed and used is 700 gallons per minute; --- acre feet per year.

5. Purpose or Purposes for which water is used irrigation

(Domestic, irrigation, municipal, manufacturing, industrial, etc.)

6. Description of Well: Depth 132 feet. Type drilled
(Dug or drilled)

diameter 12 inches. Elevation of ground at well site 220 / 77 feet, mean sea level.
(As near as known)

Depth to water table 20 feet.

7. Capacity of Well: 700 g.p.m. with 90 feet drawdown.

--- g.p.m. with --- feet drawdown.

Date of test 7-1947

If Flowing Well: Measured discharge --- g.p.m. on ---
(Date)

Shut-in pressure at ground surface --- lbs. per sq. in. on ---
(Date)

Water is controlled by ---
(Cap, valve, etc.)

If log of well is not available, give name and address of driller. Vernon Coleman

Woodburn, Oregon

11. Infiltration Trench: Covered or open _____

Dimensions: Length _____ ft. Minimum depth _____ ft. Maximum depth _____ ft.

Bottom width _____ ft. Discharge _____ g.p.m. Date of test _____

12. Tunnel: Type of lining _____

Dimensions: _____
(Length, course, and cross sectional size)

Position of water bearing stratum with reference to portal of tunnel _____

Log of tunnel: (Preceding table for log of well may be used, if desired. Give footage from portal and character of materials, as pertinent.)

13. Pumping Equipment:

(a) Pump Peyomona _____ Capacity 700 g.p.m.
(Make, type and size)


(b) Motor 40 horsepower fairbanks Morris (electric) _____
(Type and horsepower)

14. Location of area irrigated or to be irrigated, or place of use if for purposes other than irrigation.

Township North or South	Range E. or W. of Willamette Meridian	Section	Forty-acre Tract	Number Acres To Be Irrigated	Date of Reclamation
4S	2W	35	NE $\frac{1}{4}$ SE $\frac{1}{4}$	4.500	1947
"	"	"	SE $\frac{1}{4}$ NE $\frac{1}{4}$	23.631	"
"	"	"	NE $\frac{1}{4}$ NE $\frac{1}{4}$	30.412	"
"	"	26	SE $\frac{1}{4}$ SE $\frac{1}{4}$	1.893	"
"	"	36	NW $\frac{1}{4}$ NW $\frac{1}{4}$	35.640	"
"	"	"	NE $\frac{1}{4}$ NW $\frac{1}{4}$	16.758	"
"	"	"	NW $\frac{1}{4}$ NE $\frac{1}{4}$	3.271	"
"	"	"	SW $\frac{1}{4}$ NE $\frac{1}{4}$	6.714	"
"	"	"	SE $\frac{1}{4}$ NW $\frac{1}{4}$	38.969	"
"	"	"	SW $\frac{1}{4}$ NW $\frac{1}{4}$	40.00	"
"	"	"	NW $\frac{1}{4}$ SW $\frac{1}{4}$	24.213	"
"	"	"	NE $\frac{1}{4}$ SW $\frac{1}{4}$	21.177	"
				Total 247.178	

15. If the ground water supply is supplemental to an existing water supply, identification of any application for a permit, permit, certificate or adjudicated right to appropriate water made or held by the registrant.

Township 4S Range 2W, W.M.
North

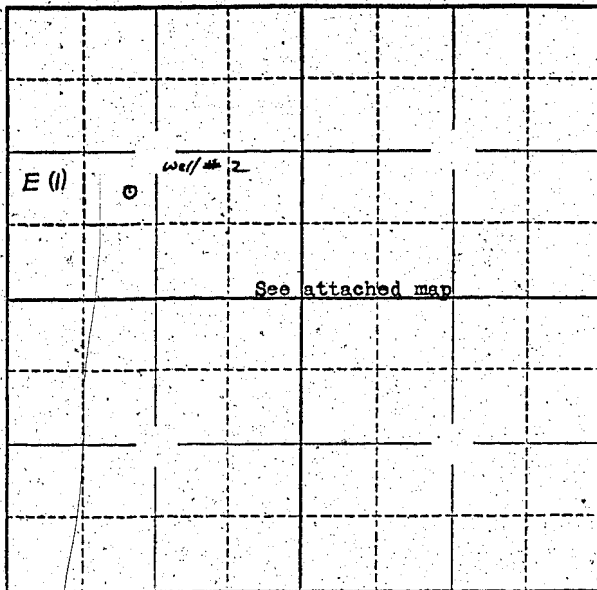

Locate well and acreage of irrigated land on plat.
Scale: 2" = 1 Mile

STATE OF OREGON

County of Marion } ss.

I, William A. Brown, being first duly sworn, do hereby certify that I have read the foregoing Registration Statement and that all of the items therein contained are true to the best of my knowledge and belief.

William A. Brown
(Signature of Registrant)

Subscribed and sworn to before me this 17 day of March, 1958

My commission expires 9/27/58

Jeanie Baxter
(Notary Public)

(SEAL)

CERTIFICATE OF REGISTRATION

STATE OF OREGON

County of Marion } ss.

This is to certify that the foregoing Registration Statement was received in the office of the State Engineer on the 17 day of March, 1958, at 10:00 o'clock A.M. and has been duly recorded in said office in Book No. 6 of Registration Statements on page GR-1162

Witness my hand this 17 day of September, 1958

Lewis A. Stanley
(State Engineer)

By _____ (Deputy)