Registration No. GR - 1204

Certificate No. GR - 1164

Registration Statement

OF CLAIMANT OF RIGHT TO APPROPRIATE GROUND WATER

TO THE STATE ENGINEER OF OREGON:

I, Alfred Schiedler Rt 1 Box 291,

of Woodburn (Mailing address) County of Marion

State of Oregon, do hereby make application for a certificate of registration as evidence of a right to appropriate ground water.

1. **Source** from which water is withdrawn is Pump well (Flowing well, pump well, infiltration trench, or tunnel)

2. **Location** is: 4½ miles N.W. Woodburn, Oregon (Approximate distance and direction from nearest city or town);

and is more particularly described as follows:

(a) 1010' S. and 260' E. of the N.W. corner of N ¼ Sect. N.W. ¼ N.E. ¼ (Give distance and bearing to corner of section or other legal subdivision)

being within N.W. ¼ of N.E. ¼ (Smallest legal subdivision) of Sec. 2, Twp. 5 S. (N. or S.), Rge. 2 W. (E. or W.)

or (b) within limits of recorded platted property, town or city:

in Lot ....., Block ..... of ..... (Name of plat or addition)

..... (If within city or town, give name) County of .....

3. **Construction Work** was begun on Apr. 20, 1951 (Date); was completed on Apr. 27, 1951 (Date)

and the ground water claimed was first used for the purposes set out below on May 30, 1951 (Date),

since which time the water has been used intermittently (Continuously or intermittently)

from May, 1951 (Date) to Mar. 1958 (Date)

4. **Quantity** of water claimed and used is 150 gallons per minute; 65 acre feet per year.

5. **Purpose or Purposes** for which water is used Irrigation

..... (Domestic, irrigation, municipal, manufacturing, industrial, etc.)

6. **Description of Well:** Depth 128 feet. Type Drilled (Dug or drilled)

diameter 10 inches. Elevation of ground at well site 178' (As near as known) feet, mean sea level.

Depth to water table 21 feet.

Pump set at 65 ft. 3 hrs.

7. **Capacity of Well:** 265 g.p.m. with 65 feet ~~drawdown~~. To

200 g.p.m. with 53 feet ~~drawdown~~. To

150 46

100 40

Date of test Apr. 25, 1951

If Flowing Well: Measured discharge ..... g.p.m. on ..... (Date)

Shut-in pressure at ground surface ..... lbs. per sq. in. on ..... (Date)

Water is controlled by ..... (Cap, valve, etc.)

4M—4-57

8. **Casing:** (Give diameter, commercial specifications and depth below ground surface of each casing size.)

10 inch diameter steel casing from 0 to 128 feet

inch diameter from to feet

inch diameter from to feet

inch diameter from to feet

Describe and show depth of shoe, plug, adapter, liner or other details: unknown

9. **Perforated Casings or Screens:**

Unknown size of slots (Number per foot and size of perforations, or describe screen) from 112 to 120

from to

from to

from to

10. **Log of Well:** (Describe each stratum or formation clearly, indicate if water bearing, and give thickness and depth as indicated.)

MATERIAL	Thickness (Feet)	Depth to Bottom (Feet)
~~Unknown~~	0	107
sand & gravel	107	120
sand	120	128

GR 1164

If log of well is not available, give name and address of driller. ~~Unknown~~

Steinmann Bros Portland 2 One

11. **Infiltration Trench:** Covered or open .....

Dimensions: Length ..... ft. Minimum depth ..... ft. Maximum depth ..... ft.

Bottom width ..... ft. Discharge ..... g.p.m. Date of test .....

12. **Tunnel:** Type of lining .....

Dimensions: .....
(Length, course, and cross sectional size)

Position of water bearing stratum with reference to portal of tunnel .....

Log of tunnel: (Preceding table for log of well may be used, if desired. Give footage from portal and character of materials, as pertinent.)

13. **Pumping Equipment:**

(a) Pump Berkley Turbine 4" (Make, type and size) Capacity 150 g.p.m.

(b) Motor 7½ HP 3 Ø 240 V. (Type and horsepower)

14. Location of area irrigated or to be irrigated, or place of use if for purposes other than irrigation.

Township North or South	Range E. or W. of Willamette Meridian	Section	Forty-acre Tract	Number Acres To Be Irrigated	Date of Reclamation
5 S	2 W	2	NE ¼ NW ¼	1.37	May 1, 1951
5 S	2 W	2	SE ¼ NW ¼	15.00	"
5 S	2 W	2	NE ¼ SW ¼	6.00	"
5 S	2 W	2	NW ¼ NE ¼	13.70	"
5 S	2 W	2	SW ¼ NE ¼	15.90	"
5 S	2 W	2	NW ¼ SE ¼	3.00	"
5 S	2 W	2	SE ¼ NE ¼	.03	"
				55.00	

15. If the ground water supply is supplemental to an existing water supply, identification of any application for a permit, permit, certificate or adjudicated right to appropriate water made or held by the registrant.

.....

.....

GR 1164

Township 5S Range 2W, W.M.

North

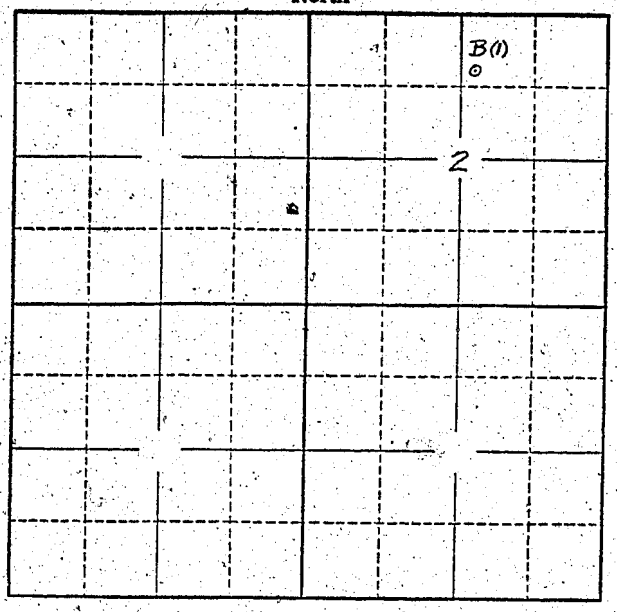

Locate well and acreage of irrigated land on plat.

Scale: 2" = 1 Mile

STATE OF OREGON
County of Marion } ss.

I, Alfred Schiedler, being first duly sworn, do hereby certify that I have read the foregoing Registration Statement and that all of the items therein contained are true to the best of my knowledge and belief.

Alfred Schiedler
(Signature of Registrant)

Subscribed and sworn to before me this 3 day of March, 19 58

My commission expires Feb. 13, 1959

R. F. Garinger
(Notary Public)

(SEAL)

CERTIFICATE OF REGISTRATION

STATE OF OREGON
County of Marion } ss.

This is to certify that the foregoing Registration Statement was received in the office of the State Engineer on the 17 day of March, 19 58, at 9 00 o'clock A M. and has been duly recorded in said office in Book No. 6 of Registration Statements on page GR-1164

Witness my hand this 17 day of September 19 58.

Lewis A. Stanley
(State Engineer)

By
(Deputy)

GR-1164