

Registration Statement

OF CLAIMANT OF RIGHT TO APPROPRIATE GROUND WATER

TO THE STATE ENGINEER OF OREGON:

I, Ralph Case
 of Star Rt Box 30 B St Paul County of Mason
(Mailing address)
 State of Oregon, do hereby make application for a certificate of registration as evidence
 of a right to appropriate ground water.

1. Source from which water is withdrawn is Pump #1
(Flowing well, pump well, infiltration trench, or tunnel)
 2. Location is: Two miles East of St. Paul
(Approximate distance and direction from nearest city or town)

and is more particularly described as follows:

(a) 2650' E & 1700' N from SW corner Section 21
(Give distance and bearing to corner of section or other legal subdivision)
 being within NW 1/4 SE 1/4 of Sec. 21, Twp. 4S, Rge. 2W
(Smallest legal subdivision) (N. or S.) (E. or W.)

or ☒ within limits of recorded platted property, town or city:
 in Lot _____, Block _____ of _____
(Name of plat or addition)

County of _____
(If within city or town, give name)
 3. Construction Work was begun on Nov 20th 1949 was completed on Dec 19th 1949
(Date) (Date)
 and the ground water claimed was first used for the purposes set out below on May 1950
(Date)
 since which time the water has been used Continuously
(Continuously or intermittently)
 from May to Oct
(Date) (Date)

4. Quantity of water claimed and used is: 290 gallons per minute; 235 acre
 feet per year.

5. Purpose or Purposes for which water is used Irrigation
(Domestic, irrigation, municipal, manufacturing, industrial, etc.)

6. Description of Well: Depth 114 feet. Type drilled
(Dug or drilled)
 diameter 10 inches. Elevation of ground at well site 170 feet, mean sea level.
(As near as known)
 Depth to water table 32 feet.

7. Capacity of Well: 290 g.p.m. with 90 feet drawdown.
 _____ g.p.m. with _____ feet drawdown.

Date of test Dec 5th 1949

If Flowing Well: Measured discharge _____ g.p.m. on _____
(Date)

Shut-in pressure at ground surface _____ lbs. per sq. in. on _____
(Date)

Water is controlled by _____
(Cap, valve, etc.)

8. Casing: (Give diameter, commercial specifications and depth below ground surface of each casing size.)

10 inch diameter from 0 to 95 feet
 inch diameter from to feet
 inch diameter from to feet
 inch diameter from to feet

Describe and show depth of shoe, plug, adapter, liner or other details:

9. Perforated Casings or Screens:

(Number per foot and size of perforations, or describe screen) from to
 from to
 from to
 from to

10. Log of Well: (Describe each stratum or formation clearly, indicate if water bearing, and give thickness and depth as indicated.)

MATERIAL	Thickness (Feet)	Depth to Bottom (Feet)
SOIL	3	3
CLAY	32	35
SAND	8	43
YELLOW CLAY	31	74
BLUE CLAY	5	79
GRAY CLAY	11	90
GREEN CLAY	9	99
BROKEN SAND & CLAY	5	104
BLACK SAND & WATER	10	114

J. J. Miller

Dimensions: Length ft. Minimum depth ft. Maximum depth ft.

12. Tunnel: Type of lining

Position of water bearing stratum with reference to portal of tunnel


13. Pumping Equipment:

(b) Motor 15 H P
(Type and horsepower)

[illegible]

GR 1165

Township 4S Range 2W, W.M.
North

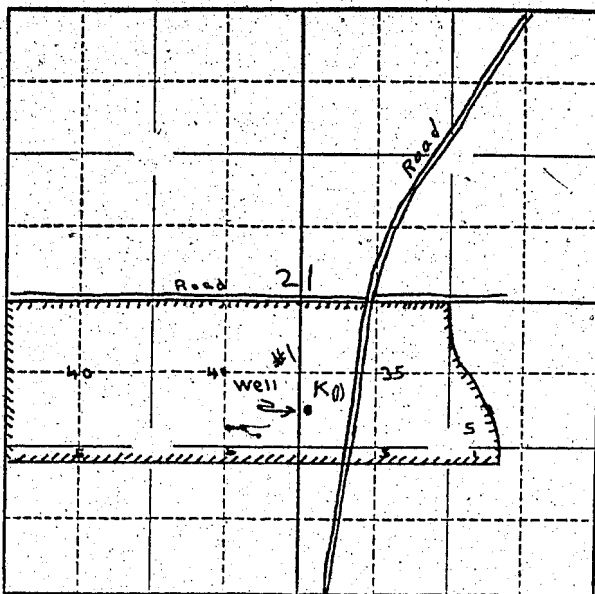

Locate well and acreage of irrigated land on plat.

Scale: $\frac{1}{4}$ " = 1 Mile

STATE OF OREGON

County of Marion

ss.

I, RALPH CASE, being first duly sworn, do hereby certify that I have read the foregoing Registration Statement and that all of the items therein contained are true to the best of my knowledge and belief.

Ralph Case
(Signature of Registrant)

Subscribed and sworn to before me this 17th day of March, 1958

My commission expires 9/27/58

(SEAL)

Jeannie Baxter
(Notary Public)

CERTIFICATE OF REGISTRATION

STATE OF OREGON

County of Marion

ss.

This is to certify that the foregoing Registration Statement was received in the office of the State Engineer on the 17th day of March, 1958, at 10⁰⁰ o'clock A. M. and has been duly recorded in said office in Book No. 6 of Registration Statements on page GR-1165

Witness my hand this 17 day of September, 1958

Lewis A. Stanley
(State Engineer)

By

(Deputy)

GR - 1165