

Registration Statement

OF CLAIMANT OF RIGHT TO APPROPRIATE GROUND WATER

TO THE STATE ENGINEER OF OREGON:

I, Robert Seymour G. Beer
of Rte 2 Box 461 Eugene County of Lane
(Mailing address)

State of Ore., do hereby make application for a certificate of registration as evidence of a right to appropriate ground water.

1. Source from which water is withdrawn is Drum Pump well
(Flowing well, pump well, infiltration trench, or tunnel)

2. Location is: 3 mi north west of Coho
(Approximate distance and direction from nearest city or town)

and is more particularly described as follows:

(a) S 10° 45' W - 410' from E 1/4 Corner Section 24
(Give distance and bearing to corner of section or other legal subdivision)

being within NE 1/4 SE 1/4 of Sec. 24, Twp. 16 S, Rge. 4W
(Smallest legal subdivision) (N. or S.) (E. or W.)

or (b) within limits of recorded platted property, town or city:

in Lot _____, Block _____ of _____
(Name of plat or addition)

County of _____
(If within city or town, give name)

3. Construction Work was begun on June 46; was completed on June 46
(Date) (Date)

and the ground water claimed was first used for the purposes set out below on June 46
(Date)

since which time the water has been used Intermittently
(Continuously or intermittently)

from May to Sept
(Date) (Date)

4. Quantity of water claimed and used is 600 gallons per minute; 36 acre feet per year.

5. Purpose or Purposes for which water is used irrigation

(Domestic, irrigation, municipal, manufacturing, industrial, etc.)

6. Description of Well: Depth 18 ft feet. Type Drum
(Dug or drilled)

diameter 3-2 inch inches. Elevation of ground at well site 355 feet, mean sea level.
(As near as known)

Depth to water table 8 feet.

7. Capacity of Well: _____ g.p.m. with 18 ft feet drawdown.

_____ g.p.m. with _____ feet drawdown.


Date of test _____

If Flowing Well: Measured discharge _____ g.p.m. on _____
(Date)

Shut-in pressure at ground surface _____ lbs. per sq. in. on _____
(Date)

Water is controlled by _____
(Cap, valve, etc.)

Township 16S Range 4W W.M.
North

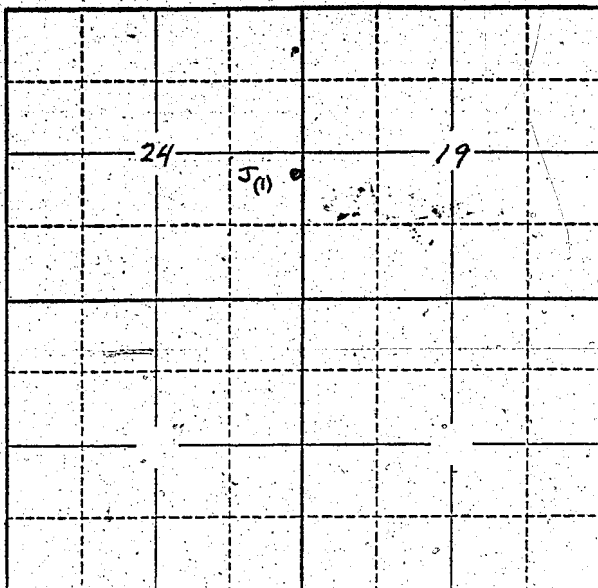

Locate well and acreage of irrigated land on plat.
Scale: 2" = 1 Mile

STATE OF OREGON }
County of Roberts } ss.

I, Roberts Geer, being first duly sworn, do hereby certify that I have read the foregoing Registration Statement and that all of the items therein contained are true to the best of my knowledge and belief.

Roberts Geer
(Signature of Registrant)

Subscribed and sworn to before me this 14th day of March, 1958

My commission expires June 25, 1961
(Notary Public)

(SEAL)

CERTIFICATE OF REGISTRATION

STATE OF OREGON }
County of Marion } ss.

This is to certify that the foregoing Registration Statement was received in the office of the State Engineer on the 19th day of March, 1958, at 8:00 o'clock A.M. and has been duly recorded in said office in Book No. 6 of Registration Statements on page GR-1174

Witness my hand this 17 day of September, 1958

Lewis A. Stanley
(State Engineer)

By _____
(Deputy)

\$1500