

RECEIVED
MAR 19 1958
STATE ENGINEER
SALEM, OREGON

Registration No. GR. - 1215
Certificate No. GR. - 1175

Registration Statement

OF CLAIMANT OF RIGHT TO APPROPRIATE GROUND WATER

TO THE STATE ENGINEER OF OREGON:

I, George M. Seifert

of Rt 2, Eugene County of Lane

(Mailing address)

State of Oregon, do hereby make application for a certificate of registration as evidence of a right to appropriate ground water.

1. Source from which water is withdrawn is Pump well #2
(Flowing well, pump well, infiltration trench, or tunnel)

2. Location is: 4 3/4 miles NW of Coburg, Oregon
(Approximate distance and direction from nearest city or town)

and is more particularly described as follows:

(a) S 1625', W 1350' from N $\frac{1}{2}$ corner Sec. 13
(Give distance and bearing to corner of section or other legal subdivision)

being within SW $\frac{1}{4}$ NW $\frac{1}{4}$ of Sec. 13, Twp. 16 S, Rge. 4 W
(Smallest legal subdivision) (N. or S.) (E. or W.)

or (b) within limits of recorded platted property, town or city:

in Lot _____, Block _____ of _____
(Name of plat or addition)

County of _____
(If within city or town, give name)

3. Construction Work was begun on 1947; was completed on 1947
(Date) (Date)

and the ground water claimed was first used for the purposes set out below on June 1947
(Date)

since which time the water has been used Intermittently
(Continuously or Intermittently)

from May or June to October
(Date) (Date)

4. Quantity of water claimed and used is 500 gallons per minute; 45 acre feet per year.

5. Purpose or Purposes for which water is used Irrigation

(Domestic, irrigation, municipal, manufacturing, industrial, etc.)

6. Description of Well: Depth 18 feet, Type Driven
(Dug or drilled)

diameter 5 inches. Elevation of ground at well site 386 more or less feet, mean sea level.
(As near as known)

Depth to water table 4 feet, approximately

7. Capacity of Well: 500 g.p.m. with 8 feet drawdown. (estimate)

_____ g.p.m. with _____ feet drawdown.

Date of test not tested


If Flowing Well: Measured discharge _____ g.p.m. on _____
(Date)

Shut-in pressure at ground surface _____ lbs. per sq. in. on _____
(Date)

Water is controlled by _____
(Cap, valve, etc.)

Well # 2

Township 16 S Range 4 W W.M.
North

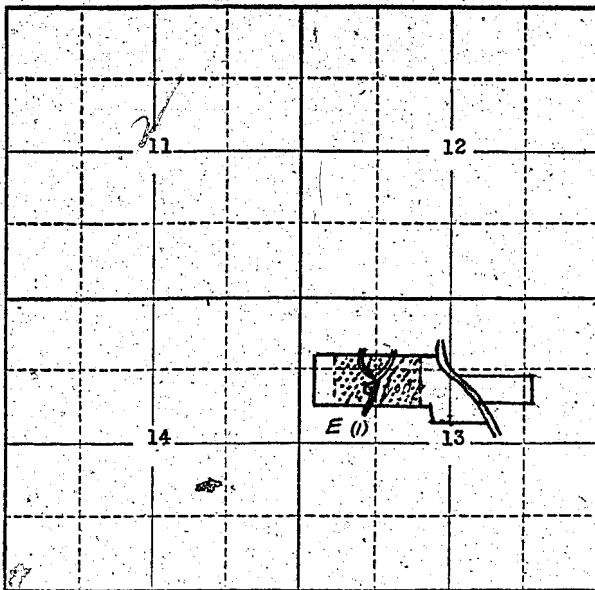

Locate well and acreage of irrigated land on plat:
Scale: 2" = 1 Mile.

STATE OF OREGON

County of Lane } ss.

I, Geo. M. Seifert, being first duly sworn, do hereby certify that I have read the foregoing Registration Statement and that all of the items therein contained are true to the best of my knowledge and belief.

Geo. M. Seifert
(Signature of Registrar)

Subscribed and sworn to before me this 17th day of March, 1958.

My commission expires August 13, 1958.

Wm. W. Underhill
(Notary Public)

(SEAL)

CERTIFICATE OF REGISTRATION

STATE OF OREGON

County of Marion } ss.

This is to certify that the foregoing Registration Statement was received in the office of the State Engineer on the 19th day of March, 1958, at 2:00 o'clock A.M. and has been duly recorded in said office in Book No. 6 of Registration Statements on page GR-1175

Witness my hand this 17 day of September, 1958.

Laura A. Stanley
(State Engineer)

\$15.00

By _____ (Deputy)

GR - 1175