

RECEIVED  
MAR 19 1958  
STATE ENGINEER  
SALEM, OREGON

Registration No. GR - 1219

Certificate No. GR - 1179

# Registration Statement

## OF CLAIMANT OF RIGHT TO APPROPRIATE GROUND WATER

TO THE STATE ENGINEER OF OREGON:

I, Walter Glasgow  
of Jefferson County of Marion  
State of Oregon, do hereby make application for a certificate of registration as evidence of a right to appropriate ground water.

1. Source from which water is withdrawn is Pump Well No 2  
(Flowing well, pump well, infiltration trench, or tunnel)

2. Location is: 1 1/2 miles S.E. Jefferson  
(Approximate distance and direction from nearest city or town)

and is more particularly described as follows:

(a) 340' S & 900' E from NW corner Section 13  
(Give distance and bearing to corner of section or other legal subdivision)

being within NW 1/4 of SW 1/4 of Sec. 13 Twp. 10S Rge. 3W  
(Smallest legal subdivision) (N, S, E, or W)

or (b) within limits of recorded platted property, town or city:

in Lot \_\_\_\_\_, Block \_\_\_\_\_ of \_\_\_\_\_  
(Name of plat or addition)

County of \_\_\_\_\_  
(If within city or town, give name)

3. Construction Work was begun on June 1945; was completed on June 1945  
(Date) (Date)

and the ground water claimed was first used for the purposes set out below on June 1st  
(Date)

since which time the water has been used intermittently during season  
(Continuously or intermittently)

from June 1st to Sept 1st  
(Date) (Date)

4. Quantity of water claimed and used is 300 gallons per minute; \_\_\_\_\_ acre feet per year.

5. Purpose or Purposes for which water is used irrigation

(Domestic, irrigation, municipal, manufacturing, industrial, etc.)

6. Description of Well: Depth 72 feet. Type Drilled  
(Dug or drilled)

diameter 8 inches. Elevation of ground at well site 225 feet; mean sea level.  
(As near as known)

Depth to water table 14 feet.

7. Capacity of Well: 250 g.p.m. with \_\_\_\_\_ feet drawdown.

\_\_\_\_\_ g.p.m. with \_\_\_\_\_ feet drawdown.

Date of test \_\_\_\_\_

If Flowing Well: Measured discharge \_\_\_\_\_ g.p.m. on \_\_\_\_\_ (Date)


Shut-in pressure at ground surface \_\_\_\_\_ lbs. per sq. in. on \_\_\_\_\_ (Date)

Water is controlled by \_\_\_\_\_  
(Cap, valve, etc.)





Township 10S Range 2W W.M.  
North

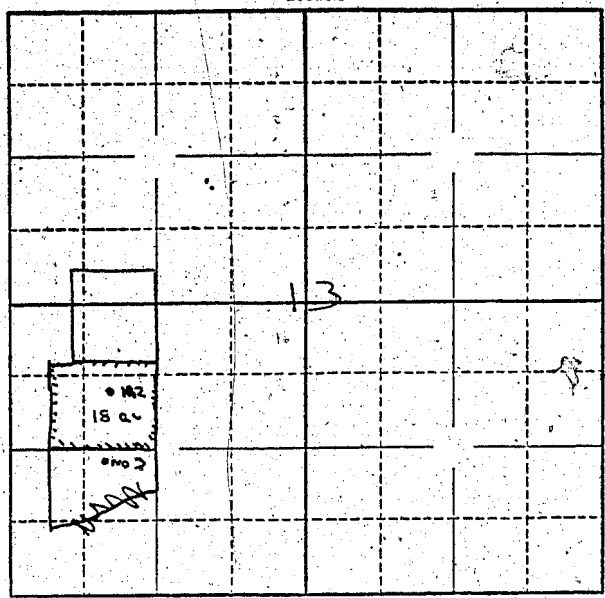

Locate well and acreage of irrigated land on plat.

Scale:  $\frac{1}{4}$ " = 1 Mile

STATE OF OREGON

County of Marion Co } ss.

I, Walter Glasgow, being first duly sworn, do hereby certify that I have read the foregoing Registration Statement and that all of the items therein contained are true to the best of my knowledge and belief.

Walter Glasgow  
(Signature of Registrant)

Subscribed and sworn to before me this 18th day of March, 1958.

My commission expires \_\_\_\_\_  
MY COMMISSION EXPIRES JULY 25, 1960

Gladys A. Shields  
(Notary Public)

(SEAL)

**CERTIFICATE OF REGISTRATION**

STATE OF OREGON } ss.  
County of Marion

This is to certify that the foregoing Registration Statement was received in the office of the State Engineer on the 19th day of March, 1958, at 1:00 o'clock P. M. and has been duly recorded in said office in Book No. 6 of Registration Statements on page GR-1179

Witness my hand this 17 day of September, 1958.

Lauria A. Stanley  
(State Engineer)

By \_\_\_\_\_  
(Deputy)

#  
15.00

GR - 1179