

RECEIVED
MAR 19 1958
STATE ENGINEER
SALEM, OREGON

Registration No. GR-1220

Certificate No. GR-1180

Registration Statement

OF CLAIMANT OF RIGHT TO APPROPRIATE GROUND WATER

TO THE STATE ENGINEER OF OREGON:

I, Walter Glasgow
of Jefferson County of Marion
(Mailing address)

State of Oregon, do hereby make application for a certificate of registration as evidence of a right to appropriate ground water.

1. Source from which water is withdrawn is Pump well #3
(Flowing well, pump well, infiltration trench, or tunnel)
2. Location is: 1 1/2 miles - S. E. - Jefferson Ave
(Approximate distance and direction from nearest city or town)

and is more particularly described as follows:

(a) 400' S & 950' E from NW Corner Section 13
(Give distance and bearing to corner of section or other legal subdivision)
being within SW 1/4 SW 1/4 of Sec. 13, Twp. 05, Rge. 3W
(Smallest legal subdivision) (N. or S.) (E. or W.)

or (b) within limits of recorded platted property, town or city:
in Lot _____, Block _____ of _____
(Name of plat or addition)

_____ County of _____
(If within city or town, give name)

3. Construction Work was begun on June 1945; was completed on June 1945
(Date) (Date)
and the ground water claimed was first used for the purposes set out below on June 1, 1945
(Date)
since which time the water has been used intermittently during season
(Continuously or intermittently)
from June 1 to Sept 1
(Date) (Date)

4. Quantity of water claimed and used is 300 gallons per minute; _____ acre feet per year.

5. Purpose or Purposes for which water is used irrigation

(Domestic, irrigation, municipal, manufacturing, industrial, etc.)
6. Description of Well: Depth 28 feet. Type Drill
(Dug or drilled)
diameter 8 inches. Elevation of ground at well site 220 feet, mean sea level.
(As near as known)
Depth to water table 12 feet.

7. Capacity of Well: _____ g.p.m. with _____ feet drawdown.
_____ g.p.m. with _____ feet drawdown.

Date of test _____

If Flowing Well: Measured discharge _____ g.p.m. on _____ (Date)

Shut-in pressure at ground surface _____ lbs. per sq. in. on _____ (Date)

Water is controlled by _____
(Cap, valve, etc.)

8. Casing: (Give diameter, commercial specifications and depth below ground surface of each casing size.)

8 inch diameter unk. from 0 to 28 feet
 inch diameter from to feet
 inch diameter from to feet
 inch diameter from to feet

Describe and show depth of shoe, plug, adapter, liner or other details:

9. Perforated Casings or Screens:

perforated from 1.6 to 28
(Number per foot and size of perforations, or describe screen)
 from to
 from to
 from to

10. Log of Well: (Describe each stratum or formation clearly, indicate if water bearing, and give thickness and depth as indicated.)

MATERIAL	Thickness (Feet)	Depth to Bottom (Feet)
<u>Log not available</u>		

If log of well is not available, give name and address of driller. Oswell West

address unknown

11. Infiltration Trench: Covered or open

Dimensions: Length ft. Minimum depth ft. Maximum depth ft.

Bottom width ft. Discharge g.p.m. Date of test

12. Tunnel: Type of lining

Dimensions:
(Length, course, and cross sectional size)

Position of water bearing stratum with reference to portal of tunnel

Log of tunnel: (Preceding table for log of well may be used, if desired. Give footage from portal and character of materials, as pertinent.)

13. Pumping Equipment:

(a) Pump Fairbanks Morris 10-H.P. 2 1/2 V³ Capacity 350 g.p.m.
(Make, type and size)


(b) Motor 10-H.P. G.E.
(Type and horsepower)

14. Location of area irrigated or to be irrigated, or place of use if for purposes other than irrigation.

Township North or South	Range E. or W. of Willamette Meridian	Section	Forty-acre Tract	Number Acres To Be Irrigated	Date of Reclamation
10 S	3 W	13	SW ¹ / ₄ SW ¹ / ₄	22	June 1945

15. If the ground water supply is supplemental to an existing water supply, identification of any application for a permit, permit, certificate or adjudicated right to appropriate water made or held by the registrant.

Township 10 S Range 3 W W.M.
North

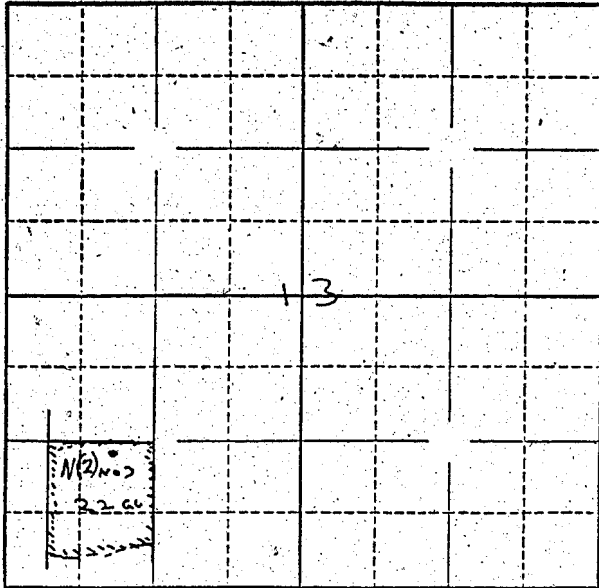

Locate well and acreage of irrigated land on plat.
Scale: 2" = 1 Mile

STATE OF OREGON

County of Marion Co } ss.

I, Walter Glasgow, being first duly sworn, do hereby certify that I have read the foregoing Registration Statement and that all of the items therein contained are true to the best of my knowledge and belief.

Walter Glasgow
(Signature of Registrant)

Subscribed and sworn to before me this 18th day of March, 1958.

My commission expires _____
MY COMMISSION EXPIRES JULY 25, 1960.

Eladep A. Shields
(Notary Public)

(SEAL)

CERTIFICATE OF REGISTRATION

STATE OF OREGON

County of Marion } ss.

This is to certify that the foregoing Registration Statement was received in the office of the State Engineer on the 19th day of March, 1958 at 1.00 o'clock P.M. and has been duly recorded in said office in Book No. 6 of Registration Statements on page GR-1180

Witness my hand this 17 day of September, 1958

Henry A. Stanley
(State Engineer)

By _____
(Deputy)