

416.65  
State Engineer  
Salem, Oregon

RECEIVED  
MAR 21 1958

STATE ENGINEER  
SALEM, OREGON

Registration No. GR - 1226

Certificate No. GR - 1185

# Registration Statement

## OF CLAIMANT OF RIGHT TO APPROPRIATE GROUND WATER

TO THE STATE ENGINEER OF OREGON:

FRANK F. HAYES

of 330 RIVER RD. Junction City County of LANE  
(Mailing address)

State of ORE, do hereby make application for a certificate of registration as evidence of a right to appropriate ground water.

1. Source from which water is withdrawn is DRIVEN  
(Flowing well, pump well, infiltration trench, or funnel)

2. Location is: 1/2 MILE N of LANCASTER  
(Approximate distance and direction from nearest city or town)

and is more particularly described as follows:

(a) 550' W & 150' N from center of Section 17  
(Give distance and bearing to corner of section or other legal subdivision)

being within SE 1/4 NW 1/4 of Sec. 17, Twp. 15S, Rge. 4W  
(Smallest legal subdivision) (N. or S.) (E. or W.)

or (b) within limits of recorded platted property, town or city:

in Lot \_\_\_\_\_, Block \_\_\_\_\_ of \_\_\_\_\_  
(Name of plat or addition)

County of \_\_\_\_\_  
(If within city or town, give name)

3. Construction Work was begun on 1940; was completed on 1940  
(Date) (Date)

and the ground water claimed was first used for the purposes set out below on 1940  
(Date)

since which time the water has been used continuously or intermittently

from MAY to SEPT  
(Date) (Date)

4. Quantity of water claimed and used is 180 gallons per minute; 100 acre feet per year.

5. Purpose or Purposes for which water is used

IRRIG (Domestic, irrigation, municipal, manufacturing, industrial, etc.)

6. Description of Well: Depth 30 feet. Type DRIVEN  
(Dug or drilled)

diameter 4 inches. Elevation of ground at well site 310 feet, mean sea level.  
(As near as known)

Depth to water table \_\_\_\_\_ feet.

7. Capacity of Well: \_\_\_\_\_ g.p.m. with \_\_\_\_\_ feet drawdown.

\_\_\_\_\_ g.p.m. with \_\_\_\_\_ feet drawdown.

Date of test Not Tested

If Flowing Well: Measured discharge \_\_\_\_\_ g.p.m. on \_\_\_\_\_  
(Date)

Shut-in pressure at ground surface \_\_\_\_\_ lbs. per sq. in. on \_\_\_\_\_  
(Date)

Water is controlled by \_\_\_\_\_  
(Cap, valve, etc.)

8. Casing: (Give diameter, commercial specifications and depth below ground surface of each casing size.)

4 inch diameter Pipe from 0 to 30 feet  
 inch diameter from to feet  
 inch diameter from to feet  
 inch diameter from to feet

Describe and show depth of shoe, plug, adapter, liner or other details:

9. Perforated Casings or Screens:

(Number per foot and size of perforations, or describe screen) from to  
 from to  
 from to  
 from to

10. Log of Well: (Describe each stratum or formation clearly, indicate if water bearing, and give thickness and depth as indicated.)

MATERIAL	Thickness (Feet)	Depth to Bottom (Feet)
Gravel		

If log of well is not available, give name and address of driller.....

11. Infiltration Trench: Covered or open .....

Dimensions: Length ..... ft. Minimum depth ..... ft. Maximum depth ..... ft.  
 Bottom width ..... ft. Discharge ..... g.p.m. Date of test .....

12. Tunnel: Type of lining .....

Dimensions: .....  
(Length, course, and cross sectional size)  
 Position of water bearing stratum with reference to portal of tunnel .....

Log of tunnel: (Preceding table for log of well may be used, if desired. Give footage from portal and character of materials, as pertinent.)

13. Pumping Equipment:


(a) Pump BERKELEY Centrifugal Capacity 180 g.p.m.  
(Make, type and size)  
 (b) Motor Elec. 10 HP  
(Type and horsepower)

14. Location of area irrigated or to be irrigated, or place of use if for purposes other than irrigation.

Township North or South	RANGE E. or W. of Willamette Meridian	Section	Forty-acre Tract	Number Acres To Be Irrigated	Date of Reclamation
15S	4W	17	SE <sup>1</sup> / <sub>4</sub> NW <sup>1</sup> / <sub>4</sub>	15	1940
"	"	"	SW <sup>1</sup> / <sub>4</sub> NE <sup>1</sup> / <sub>4</sub>	1	1940
"	"	"	NE <sup>1</sup> / <sub>4</sub> SW <sup>1</sup> / <sub>4</sub>	23	1940
"	"	"	NW <sup>1</sup> / <sub>4</sub> SE <sup>1</sup> / <sub>4</sub>	2	1940
				Total 41	

15. If the ground water supply is supplemental to an existing water supply, identification of any application for a permit, permit, certificate or adjudicated right to appropriate water made or held by the registrant.

Township 15S Range 4W W.M.  
North

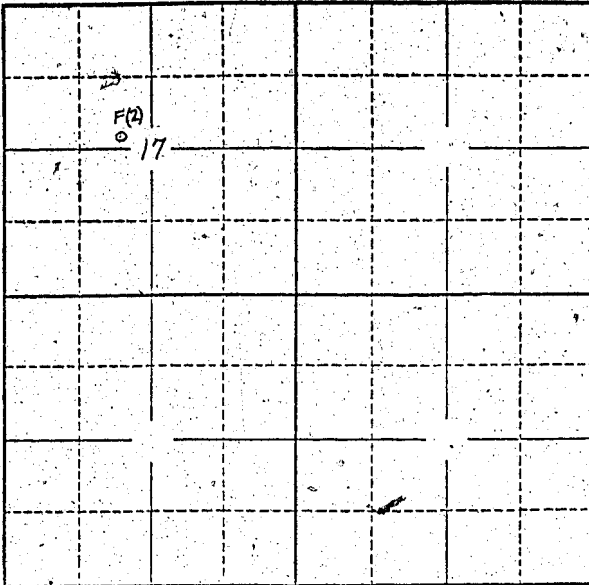

Locate well and acreage of irrigated land on plat.  
Scale: 2" = 1 Mile

STATE OF OREGON }  
County of Lane } ss.

I, Frank F. Hayes, being first duly sworn, do hereby certify that I have read the foregoing Registration Statement and that all of the items therein contained are true to the best of my knowledge and belief.

Frank F. Hayes  
(Signature of Registrant)

Subscribed and sworn to before me this 20th day of March, 19 56

My commission expires March 13, 1961

[Signature]  
(Notary Public)

(SEAL)

**CERTIFICATE OF REGISTRATION**

STATE OF OREGON }  
County of Marion } ss.

This is to certify that the foregoing Registration Statement was received in the office of the State Engineer on the 21st day of March, 19 56, at 8:00 o'clock A. M. and has been duly recorded in said office in Book No. 6 of Registration Statements on page GR-1185

Witness my hand this 17 day of September, 19 58

Lewis A. Stanley  
(State Engineer)

15.00

By \_\_\_\_\_ (Deputy)

GR - 1185