

**Registration Statement****OF CLAIMANT OF RIGHT TO APPROPRIATE GROUND WATER**

(Under Chapter 708, Oregon Laws 1955.)

**TO THE STATE ENGINEER OF OREGON:**

I, A. H. BECKERDEE  
 of AURORA, P.O. BOX 210 County of MARION  
 State of ORE., do hereby make application for a certificate of registration as evidence  
 of a right to appropriate ground water.

1. Source from which water is withdrawn is DRILLED WELL  
(Flowing well, pump well, infiltration trench, or tunnel)
2. Location is: 1 1/2 MILES SOUTH + 1/4 MILE WEST OF DONALD, ORE.  
(Approximate distance and direction from nearest city or town)

and is more particularly described as follows:

(a) 430 ft. south and 1200 feet east from W 1/4 corner section 19  
(Give distance and bearing to corner of section or other legal subdivision)  
 being within NW 1/4 of SW 1/4 of Sec. 19, Twp. 4S, Rge. 1W  
(Smallest legal subdivision) (N. or S.) (E. or W.)

or (b) within limits of recorded platted property; town or city:

in Lot 8-9-12-13, Block \_\_\_\_\_ of Miller acre  
(Name of plat or addition)  
 County of Marion  
(If within city or town, give name)

3. Construction Work was begun on MARCH 1, 1953; was completed on MARCH 9, 1953  
(Date) (Date)  
 and the ground water claimed was first used for the purposes set out below on MAY 1953  
(Date)  
 since which time the water has been used INTERMITTENTLY FOR IRRIGATION  
(Continuously or intermittently)  
 from MAY 1953 to SEPT  
(Date) (Date)

4. Quantity of water claimed and used is 150 gallons per minute; 20 acre-foot per year.

5. Purpose or Purposes for which water is used IRRIGATION  
(Domestic, irrigation, municipal, manufacturing, industrial, etc.)

6. Description of Well: Depth 130 feet. Type DRILLED  
(Dug or drilled)  
 diameter 10 inches. Elevation of ground at well site 160 feet, mean sea level.  
(As near as known)  
 Depth to water table 22 feet.


7. Capacity of Well: 150 g.p.m. with 58 feet drawdown.  
450 g.p.m. with 94 feet drawdown.

Date of test MARCH 9, 1953If Flowing Well: Measured discharge \_\_\_\_\_ g.p.m. on \_\_\_\_\_  
(Date)Shut-in pressure at ground surface \_\_\_\_\_ lbs. per sq. in. on \_\_\_\_\_  
(Date)Water is controlled by \_\_\_\_\_  
(Cap, valve, etc.)





Township 4S Range 1W, W.M.  
North

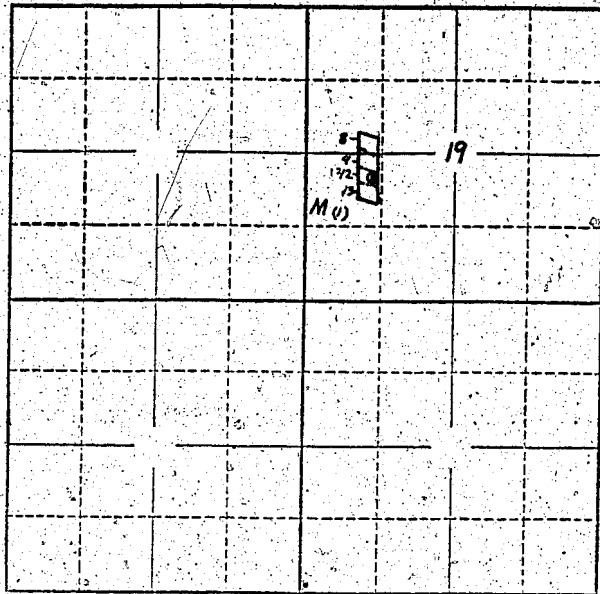

Locate well and acreage of irrigated land on plat.  
Scale: 2" = 1 Mile

STATE OF OREGON }  
County of Marion } ss.

I, A. H. Bakebrade, being first duly sworn, do hereby certify that I have read the foregoing Registration Statement and that all of the items therein contained are true to the best of my knowledge and belief.

A. H. Bakebrade  
(Signature of Registrant)

Subscribed and sworn to before me this 23<sup>rd</sup> day of February, 1956.

My commission expires Sept. 8, 1956 Chas. T. Miller  
(Notary Public)

(SEAL)

### CERTIFICATE OF REGISTRATION

STATE OF OREGON }  
County of Marion } ss.

This is to certify that the foregoing Registration Statement was received in the office of the State Engineer on the 23rd day of February, 1956, at 3:20 o'clock P. M. and has been duly recorded in said office in Book No. 1 of Registration Statements on page GR-111C

~~Construction shall be completed by \_\_\_\_\_ and the water completely applied to \_\_\_\_\_~~

Witness my hand this 12th day of April, 1956

Luvs A. Stanley  
(State Engineer)

By \_\_\_\_\_  
(Deputy)

GR-114 C