

RECEIVED
MAR 24 1958

STATE ENGINEER
SALEM, OREGON

Registration Statement

REGISTRATION NO. GR-1231
CERTIFICATE NO. GR-1190

OF CLAIMANT OF RIGHT TO APPROPRIATE GROUND WATER

(Under Chapter 708, Oregon Laws 1955.)

TO THE STATE ENGINEER OF OREGON:

I, Kate D. Sidwell

of at 2, Eugene Box 364 County of Lane

State of Oregon, do hereby make application for a certificate of registration as evidence of a right to appropriate ground water.

1. Source from which water is withdrawn is Pump well
(Flowing well, pump well, infiltration trench, or tunnel)

2. Location is: Three quarter mile west of Coburn, Oregon
(Approximate distance and direction from nearest city or town)

and is more particularly described as follows:

(a) 2440 ft south and 1430 ft east of the SW corner of Sec 32 TWP 16S Rge 3E
(Give distance and bearing to corner of section or other legal subdivision)

being within SW 1/4 OF THE NW 1/4 of Sec. 32, Twp. 16 S Rge. 3E
(Smallest legal subdivision) (N. or S.) (E. or W.)

or (b) within limits of recorded platted property, town or city:

in Lot _____, Block _____ of _____
(Name of plat or addition)

County of _____
(If within city or town, give name)

3. Construction Work was begun on 1929; was completed on 1929
(Date) (Date)

and the ground water claimed was first used for the purposes set out below on 1929
(Date)

since which time the water has been used continuously
(Continuously or intermittently)

from 1929 to 1958
(Date) (Date)

4. Quantity of water claimed and used is 200 gallons per minute; 72 acre feet per year.

5. Purpose or Purposes for which water is used Irrigation
(Domestic, irrigation, municipal, manufacturing, industrial, etc.)

6. Description of Well: Depth 16 feet. Type dug & cased with concrete pipe
(Dug or drilled)

diameter 36 inches. Elevation of ground at well site 385 feet, mean sea level.
(As near as known)

Depth to water table 12 feet.

7. Capacity of Well: 200 g.p.m. with 2 feet drawdown.
Estimated to be total capacity unless deepened
g.p.m. with _____ feet drawdown.

Date of test During irrigation June 1957


If Flowing Well: Measured discharge _____ g.p.m. on _____
(Date)

Shut-in pressure at ground surface _____ lbs. per sq. in. on _____
(Date)

Water is controlled by _____
(Cap, valve, etc.)

Township 16S Range 5W, W.M.

North

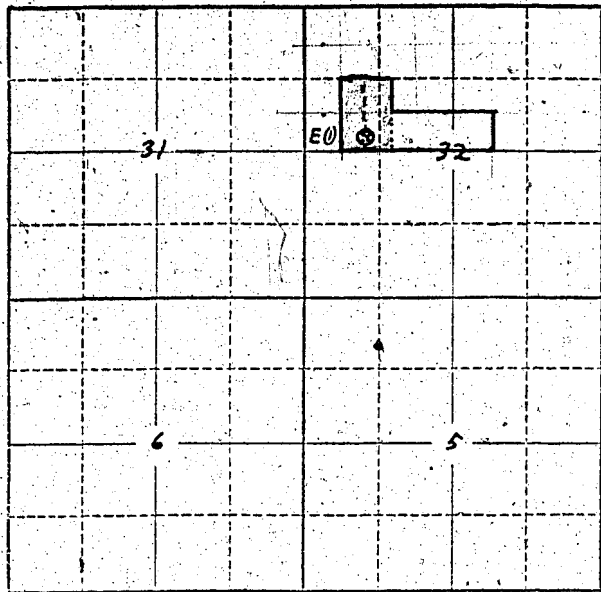

Locate well and acreage of irrigated land on plat.
Scale: 2" = 1 Mile

STATE OF OREGON

County of LANE } ss.

I, Kate D. Ridwell, being first duly sworn, do hereby certify that I have read the foregoing Registration Statement and that all of the items therein contained are true to the best of my knowledge and belief.

Kate D. Ridwell
(Signature of Registrant)

Subscribed and sworn to before me this 9th day of March, 1958

My commission expires 7-1-1959
(Notary Public)

(SEAL)

CERTIFICATE OF REGISTRATION

STATE OF OREGON

County of Marion } ss.

This is to certify that the foregoing Registration Statement was received in the office of the State Engineer on the 24th day of March, 1958, at 9:00 o'clock A.M. and has been duly recorded in said office in Book No. 6 of Registration Statements on page GR-1190


Witness my hand this 17 day of September, 1958

Lewis A. Stanley
(State Engineer)

By _____
(Deputy)

GR-1190