

RECEIVED
MAR 24 1958
STATE ENGINEER
SALEM, OREGON

Registration Statement

REGISTRATION NO. GR-1232
CERTIFICATE NO. GR-1191

OF CLAIMANT OF RIGHT TO APPROPRIATE GROUND WATER

(Under Chapter 708, Oregon Laws 1955.)

TO THE STATE ENGINEER OF OREGON:

I, Kate D. Sidwell

of Rt 2 Eugene Box 364 County of Lane

State of Oregon, do hereby make application for a certificate of registration as evidence of a right to appropriate ground water.

1. Source from which water is withdrawn is Pump well
(Flowing well, pump well, infiltration trench, or tunnel)

2. Location is: One half mile west of Coburg, Oregon
(Approximate distance and direction from nearest city or town)

and is more particularly described as follows:

(a) 2340 ft south and 2820 ft east of the NE corner of Sec. 32
(Give distance and bearing to corner of section or other legal subdivision)

being within SW 1/4 NE 1/4 of Sec. 32, Twp. 16 S, Rge. 3 W
(Smallest legal subdivision) (N. or S.) (E. or W.)

or (b) within limits of recorded platted property, town or city:

in Lot _____, Block _____ of _____
(Name of plat or addition)

(If within city or town, give name)

3. Construction Work was begun on 1929 (Date), was completed on 1929 (Date)

and the ground water claimed was first used for the purposes set out below on 1929 (Date)

since which time the water has been used continuous
(Continuously or intermittently)

from 1929 (Date) to 1958 (Date)

4. Quantity of water claimed and used is 160 gallons per minute; 72 acre feet per year.

5. Purpose or Purposes for which water is used Irrigation

(Domestic, irrigation, municipal, manufacturing, industrial, etc.)

6. Description of Well: Depth 20 feet. Type Dug and cased

(Dug or drilled)

diameter 24 inches. Elevation of ground at well site 385 feet, mean sea level.
(As near as known)

Depth to water table 10 feet.

7. Capacity of Well: 160 g.p.m. with 1 feet drawdown.

Will produce much more - estimate up to 500 gpm
g.p.m. with _____ feet drawdown.


Date of test _____

If Flowing Well: Measured discharge _____ g.p.m. on _____ (Date)

Shut-in pressure at ground surface _____ lbs. per sq. in. on _____ (Date)

Water is controlled by _____
(Cap, valve, etc.)

Township 16 S Range 3 W, W.M.
North

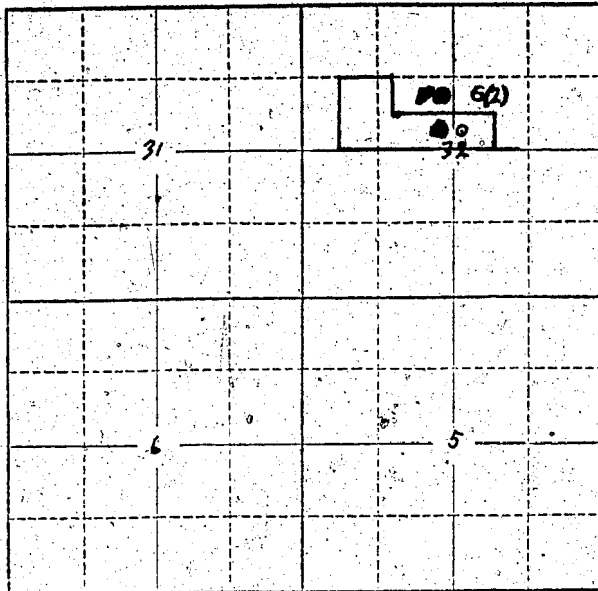

Locate well and acreage of irrigated land on plat.
Scale: 2" = 1 Mile.

STATE OF OREGON }
County of LANE } ss.

I, Kate D. Kidwell, being first duly sworn, do hereby certify that I have read the foregoing Registration Statement and that all of the items therein contained are true to the best of my knowledge and belief.

Kate D. Kidwell
(Signature of Registrant)

Subscribed and sworn to before me this 11 day of August, 1928.

My commission expires Aug 16 1929
(Notary Public)

(SEAL)

CERTIFICATE OF REGISTRATION

STATE OF OREGON }
County of Marion } ss.

This is to certify that the foregoing Registration Statement was received in the office of the State Engineer on the 24th day of March, 1928, at 8.00 o'clock A.M. and has been duly recorded in said office in Book No. 6 of Registration Statements on page GR-1191

Witness my hand this 17 day of September, 1928.

Lewis A. Stanley
(State Engineer)

By _____
(Deputy)

GR-1191