

RECEIVED  
MAR 21 1958  
STATE ENGINEER  
SALEM, OREGON

Registration No. GR - 1234  
Certificate No. GR - 1193

# Registration Statement

## OF CLAIMANT OF RIGHT TO APPROPRIATE GROUND WATER

TO THE STATE ENGINEER OF OREGON:

Reta Crow.

of Milton-Freewater, R.# 2, Box 63A. County of Umatilla  
(Mailing address)

State of Oregon., do hereby make application for a certificate of registration as evidence of a right to appropriate ground water.

1. Source from which water is withdrawn is Pump well  
(Flowing well, pump well, infiltration trench, or tunnel)

2. Location is: 3 miles.  
(Approximate distance and direction from nearest city or town)

and is more particularly described as follows:

(a) pt. -- 40 ft. W from a pt. 320 ft. N. from SE cor. of NW 1/4 of  
(Give distance and bearing to corner of section or other legal subdivision) NW 1/4 Sec. 33, Tp. 6  
being within NW 1/4 of NW 1/4 of Sec. 33, Twp. 6 N. R. 35 E. W. M.  
(Smallest legal subdivision) (N. or S.) (E. or W.)

or (b) within limits of recorded platted property, town or city: \_\_\_\_\_

in Lot \_\_\_\_\_, Block \_\_\_\_\_ of \_\_\_\_\_  
(Name of plat or addition)

County of \_\_\_\_\_  
(If within city or town, give name)

3. Construction Work was begun on prior to 1920; was completed on prior to 1920  
(Date) (Date)

and the ground water claimed was first used for the purposes set out below on prior to 1920  
(Date)

since which time the water has been used continuously  
(Continuously or intermittently)

from prior to 1920 to sept 1st. 1957.  
(Date) (Date)

4. Quantity of water claimed and used is 230 gallons per minute; 156 acre feet per year.

5. Purpose or Purposes for which water is used \_\_\_\_\_

Irrigation  
(Domestic, irrigation, municipal, manufacturing, industrial, etc.)

6. Description of Well: Depth 40 feet. Type Dug well, 6x6' - cement curb, 10' deep  
(Dug or drilled)

diameter \_\_\_\_\_ inches. Elevation of ground at well site 800 feet, mean sea level.  
(As near as known)

Depth to water table 20 feet. June

7. Capacity of Well: 250 g.p.m. with 10 feet drawdown. Varies

\_\_\_\_\_ g.p.m. with \_\_\_\_\_ feet drawdown.

Date of test no test

If Flowing Well: Measured discharge \_\_\_\_\_ g.p.m. on \_\_\_\_\_  
(Date)

Shut-in pressure at ground surface \_\_\_\_\_ lbs. per sq. in. on \_\_\_\_\_  
(Date)


Water is controlled by \_\_\_\_\_  
(Cap, valve, etc.)





Township 6N Range 35E, W.M.

North

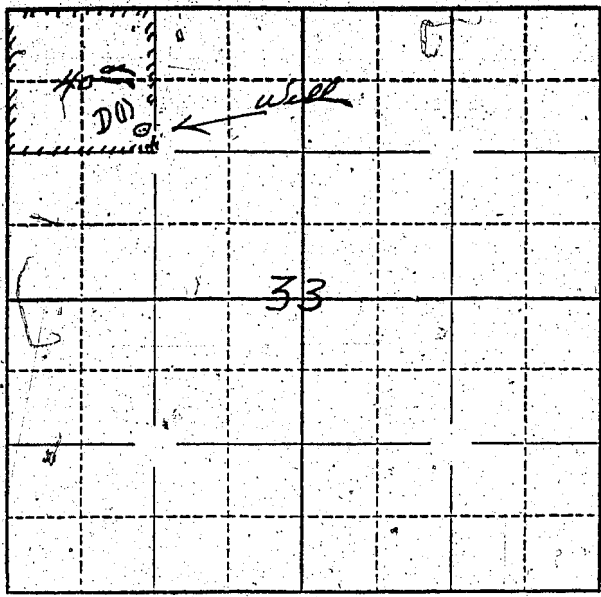

Locate well and acreage of irrigated land on plat.

Scale: 2" = 1 Mile  
4" = 1 mi

STATE OF OREGON

County of Umatilla } ss.

I, Pete Gow, being first duly sworn, do hereby certify that I have read the foregoing Registration Statement and that all of the items therein contained are true to the best of my knowledge and belief.

Pete Gow  
(Signature of Registrant)

Subscribed and sworn to before me this 21 day of March, 1958.

My commission expires 6/24/59

J.D. Fullerton  
(Notary Public)

(SEAL)

**CERTIFICATE OF REGISTRATION**

STATE OF OREGON

County of Marion } ss.

This is to certify that the foregoing Registration Statement was received in the office of the State Engineer on the 24th day of March, 1958, at 8:00 o'clock A.M. and has been duly recorded in said office in Book No. 6 of Registration Statements on page GR-1193

Witness my hand this 17 day of September, 1958

Lewis A. Stanley  
(State Engineer)

By \_\_\_\_\_ (Deputy)

#16.53

GR-1193