

# Registration Statement

## OF CLAIMANT OF RIGHT TO APPROPRIATE GROUND WATER

(Under Chapter 703, Oregon Laws 1955.)

TO THE STATE ENGINEER OF OREGON:

I, PETER PRANTL  
of GERVAIS County of MARION

State of OREGON, do hereby make application for a certificate of registration as evidence of a right to appropriate ground water.

1. Source from which water is withdrawn is Pump Well  
(Flowing well, pump well, infiltration trench, or tunnel)

2. Location is: 1/2 mile EAST of Gervais  
(Approximate distance and direction from nearest city or town)

and is more particularly described as follows:

(a) 787' N and 383' E from SW corner of Cor NE 1/4 of the S 1/4  
(Give distance and bearing to corner of section or other legal subdivision)

being within NE 1/4 of the SE 1/4 of Sec. 36, Twp. 5 S, Rge. 2 W  
(Smallest legal subdivision) (N. or S.) (E. or W.)

or (b) within limits of recorded platted property, town or city:

in Lot \_\_\_\_\_, Block \_\_\_\_\_ of \_\_\_\_\_  
(Name of plat or addition)

County of Marion  
(If within city or town, give name)

3. Construction Work was begun on MARCH 1; was completed on APRIL 3, 1952  
(Date) (Date)

and the ground water claimed was first used for the purposes set out below on MAY 15, 1952  
(Date)

since which time the water has been used Intermittently  
(Continuously or Intermittently)

from May 15, 1952 to date  
(Date) (Date)

4. Quantity of water claimed and used is 300 gallons per minute; \_\_\_\_\_ acre feet per year.

5. Purpose or Purposes for which water is used IRrigation  
(Domestic, irrigation, municipal, manufacturing, industrial, etc.)

6. Description of Well: Depth 123 feet. Type drilled  
(Dug or drilled)

diameter 10 inches. Elevation of ground at well site 170 feet, mean sea level.  
(As near as known)

Depth to water table 19 feet.

7. Capacity of Well: 250 g.p.m. with 4.9 feet drawdown.

250 g.p.m. with 7.5 feet drawdown.

Date of test MAR 9, 1952

If Flowing Well: Measured discharge \_\_\_\_\_ g.p.m. on \_\_\_\_\_  
(Date)


Shut-in pressure at ground surface \_\_\_\_\_ lbs. per sq. in. on \_\_\_\_\_  
(Date)

Water is controlled by \_\_\_\_\_  
(Cap, valve, etc.)





Township 55 Range 2 W.M.  
North

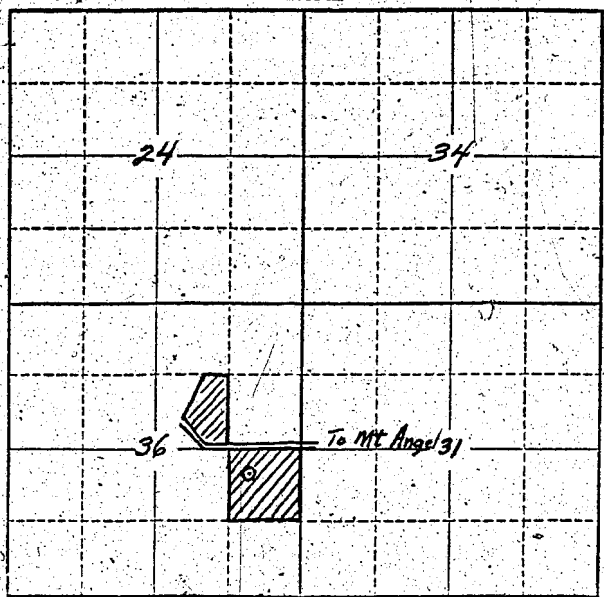

Locate well and acreage of irrigated land on plat.  
Scale: 2" = 1 Mile

STATE OF OREGON

County of Marion } ss.

I, Peter Krantz, being first duly sworn, do hereby certify that I have read the foregoing Registration Statement and that all of the items therein contained are true to the best of my knowledge and belief.

Peter Krantz

(Signature of Registrant)

Subscribed and sworn to before me this 21th day of February, 1956

My commission expires 8-22-57

W. B. Muddsmith

(Notary Public)

(SEAL)

**CERTIFICATE OF REGISTRATION**

STATE OF OREGON

County of Marion } ss.

This is to certify that the foregoing Registration Statement was received in the office of the State Engineer on the 24th day of February, 1956, at 10:30 o'clock A.M. and has been duly recorded in said office in Book No. 1 of Registration Statements on page GR-115C

~~Construction shall be completed by \_\_\_\_\_ and the water completely applied to beneficial use by \_\_\_\_\_~~

Witness my hand this 12th day of April, 1956

Lewis A. Stanley

(State Engineer)

By \_\_\_\_\_ (Deputy)

GR-115 C