15.00

RECEIVED
MAR 24 1958
STATE ENGINEER
SALEM, OREGON

Registration No. GR - 1247

Certificate No. GR - 1204

Registration Statement

OF CLAIMANT OF RIGHT TO APPROPRIATE GROUND WATER

TO THE STATE ENGINEER OF OREGON:

I, William E. BARBEE,

of 941 RIVER LOOP 2 (Mailing address) Eugene County of LANE

State of ORE, do hereby make application for a certificate of registration as evidence of a right to appropriate ground water.

1. **Source** from which water is withdrawn is Pump Well #2 (Flowing well, pump well, infiltration trench, or tunnel)

2. **Location** is: 8 mi N of Eugene (Approximate distance and direction from nearest city or town);

and is more particularly described as follows:

(a) 1815' E & from WEST 1/4 CORNER Sec 1 (Give distance and bearing to corner of section or other legal subdivision)

being within SE/NW (Smallest legal subdivision) of Sec. 1, Twp. 17 S (N. or S.), Rge. 4W (E. or W.)

or (b) within limits of recorded platted property, town or city:

in Lot ....., Block ..... of ..... (Name of plat or addition)

..... (If within city or town, give name) County of .....

3. **Construction Work** was begun on May 1941 (Date); was completed on May 1941 (Date)

and the ground water claimed was first used for the purposes set out below on May 1941 (Date),

since which time the water has been used Cont. (Continuously or intermittently)

from May (Date) to Sept. (Date).

4. **Quantity** of water claimed and used is 140 gallons per minute; 21 acre feet per year.

5. **Purpose or Purposes** for which water is used IRRI

..... (Domestic, irrigation, municipal, manufacturing, industrial, etc.)

6. **Description of Well:** Depth 20 feet. Type DRIVEN (Dug or drilled)

diameter (2) 2" inches. Elevation of ground at well site 400' (As near as known) feet, mean sea level.

Depth to water table 5 feet.

7. **Capacity of Well:** ..... g.p.m. with ..... feet drawdown.

..... g.p.m. with ..... feet drawdown.

Date of test .....

If Flowing Well: Measured discharge ..... g.p.m. on ..... (Date)

Shut-in pressure at ground surface ..... lbs. per sq. in. on ..... (Date)

Water is controlled by ..... (Cap, valve, etc.)

4M—4-57

8. **Casing:** (Give diameter, commercial specifications and depth below ground surface of each casing size.)

(2) 2" Pipes are driven to 20' 8' apart. They are tied together 2' underground and a 3" pipe rises vertically to pump.

..... inch diameter ..... from ..... to ..... feet

..... inch diameter ..... from ..... to ..... feet

..... inch diameter ..... from ..... to ..... feet

..... inch diameter ..... from ..... to ..... feet

Describe and show depth of shoe, plug, adapter, liner or other details: .....

9. **Perforated Casings or Screens:**

3/8" x 6" from 16' to 20'
(Number per foot and size of perforations, or describe screen)

..... from ..... to .....

..... from ..... to .....

..... from ..... to .....

10. **Log of Well:** (Describe each stratum or formation clearly, indicate if water bearing, and give thickness and depth as indicated.)

MATERIAL	Thickness (Feet)	Depth to Bottom (Feet)
Not Known		

GR 1204

If log of well is not available, give name and address of driller. .....

11. **Infiltration Trench:** Covered or open .....

Dimensions: Length ..... ft. Minimum depth ..... ft. Maximum depth ..... ft.

Bottom width ..... ft. Discharge ..... g.p.m. Date of test .....

12. **Tunnel:** Type of lining .....

Dimensions: .....
(Length, course, and cross sectional size)

Position of water bearing stratum with reference to portal of tunnel .....

Log of tunnel: (Preceding table for log of well may be used, if desired. Give footage from portal and character of materials, as pertinent.)

13. **Pumping Equipment:**

(a) Pump Centrif 2" Fairbanks Morse Capacity 140 g.p.m.
(Make, type and size)

(b) Motor 5 HP 3 ϕ Elec
(Type and horsepower)

14. Location of area irrigated or to be irrigated, or place of use if for purposes other than irrigation.

Township North or South	Range E. or W. of Willamette Meridian	Section	Forty-acre Tract	Number Acres To Be Irrigated	Date of Reclamation
17 S	4 W	1	SE 1/4 NW 1/4	5.6	May 1941
"	"	"	NE 1/4 SW 1/4	2.8	✓
				8.4	

15. If the ground water supply is supplemental to an existing water supply, identification of any application for a permit, permit, certificate or adjudicated right to appropriate water made or held by the registrant.

.....

.....

GR 1204

Township 17S Range 4W, W.M.

North

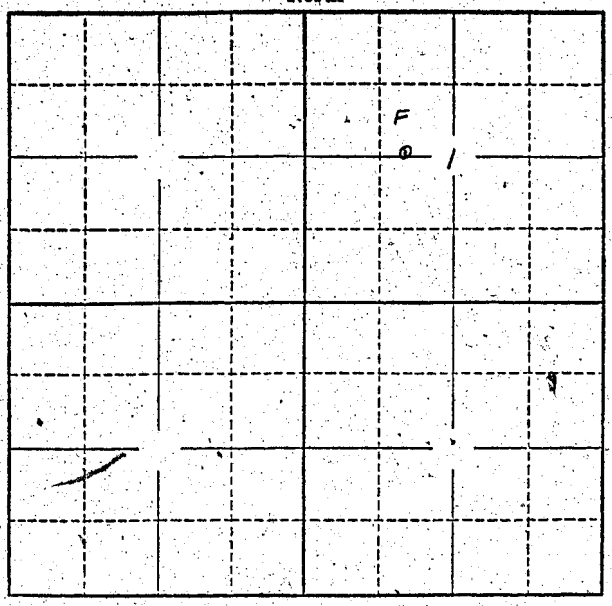

Locate well and acreage of irrigated land on plat.

Scale: 2" — 1 Mile

STATE OF OREGON
County of Lane } ss.

I, William E. Barbee being first duly sworn, do hereby certify that I have read the foregoing Registration Statement and that all of the items therein contained are true to the best of my knowledge and belief.

William E. Barbee
(Signature of Registrant)

Subscribed and sworn to before me this 21st day of March, 1958.

My commission expires NOTARY PUBLIC FOR OREGON
My Commission Expires Oct. 16, 1959
Robert G. Irwin
(Notary Public)

(SEAL)

CERTIFICATE OF REGISTRATION

STATE OF OREGON
County of Marion } ss.

This is to certify that the foregoing Registration Statement was received in the office of the State Engineer on the 24th day of March, 1958, at 8:00 o'clock A M. and has been duly recorded in said office in Book No. 6 of Registration Statements on page GR-1204

Witness my hand this 17 day of September, 1958

Lewis A. Stanley
(State Engineer)

$15.00

By
(Deputy)

GR-1204