

# Registration Statement

## OF CLAIMANT OF RIGHT TO APPROPRIATE GROUND WATER

(Under Chapter 708, Oregon Laws 1955.)

TO THE STATE ENGINEER OF OREGON:

I, Mt. Angel Abbey

of St. Benedict, Ore County of Marion

State of Oregon, do hereby make application for a certificate of registration as evidence of a right to appropriate ground water.

1. Source from which water is withdrawn is Pump Well  
(Flowing well, pump well, infiltration trench, or tunnel)

2. Location is: 200 ft South of Mt. Angel, Oregon.  
(Approximate distance and direction from nearest city or town)

and is more particularly described as follows:

(a) 62ft. E. & 31 ft. S. of iron stake which is 20 ft. East of SW corner of lot 21  
(Give distance and bearing to corner of section or other legal subdivision) Benedictine Addition to  
being within NE $\frac{1}{4}$  of SE $\frac{1}{4}$  of Sec. 10, Twp. 6 S, Rge. 1 W, Mt. Angel, Oregon.  
(Smallest legal subdivision) (N. or S.) (E. or W.)

or (b) within limits of recorded platted property, town or city:

in Lot \_\_\_\_\_, Block \_\_\_\_\_ of \_\_\_\_\_  
(Name of plat or addition)

County of \_\_\_\_\_  
(If within city or town, give name)

3. Construction Work was begun on June 1940; was completed on July 1940  
(Date) (Date)

and the ground water claimed was first used for the purposes set out below on Aug 1940  
(Date)

since which time the water has been used continuously  
(Continuously or intermittently)

from Aug 1940 to now 1955, Dec.  
(Date) (Date)

4. Quantity of water claimed and used is 200 gallons per minute; \_\_\_\_\_ acre feet per year.  
E. 40,000 gal. per day.

5. Purpose or Purposes for which water is used Irrigation, domestic, school and stock  
(Domestic, irrigation, municipal, manufacturing, industrial, etc.)

6. Description of Well: Depth 172 feet. Type Drilled  
(Dug or drilled)

diameter 12 inches. Elevation of ground at well site 180 feet, mean sea level.  
(As near as known)

Depth to water table 41 feet.

7. Capacity of Well: 200 g.p.m. with 40 feet drawdown.  
\_\_\_\_\_ g.p.m. with \_\_\_\_\_ feet drawdown.

Date of test July 1940 and October 1955

If Flowing Well: Measured discharge \_\_\_\_\_ g.p.m. on \_\_\_\_\_  
(Date)

Shut-in pressure at ground surface \_\_\_\_\_ lbs. per sq. in. on \_\_\_\_\_  
(Date)

Water is controlled by \_\_\_\_\_  
(Cap, valve, etc.)

8. Casing: (Give diameter, commercial specifications and depth below ground surface of each casing size.)

12 inch diameter Heavy Steel from 0 to 172 feet  
 inch diameter from to feet  
 inch diameter from to feet  
 inch diameter from to feet

Describe and show depth of shoe, plug, adapter, liner or other details:

9. Perforated Casings or Screens:


1" x  $\frac{1}{4}$  or  $\frac{3}{8}$  from 45' to 47'  
(Number per foot and size of perforations, or describe screen)  
 from 48' to 53'  
 from 83' to 88'  
 from 91' to 103'  
 from 120' to 128'  
 from 133' to 145'  
 from 152' to 167'

10. Log of Well: (Describe each stratum or formation clearly, indicate if water bearing, and give thickness and depth as indicated.)

MATERIAL	Thickness (Feet)	Depth to Bottom (Feet)
Top Soil	4'	4'
Yellow Clay	20'	24'
Blue Clay	8'	32'
Boulders and Gravel	21'	53'
Yellow Muck	7'	60'
Sandy Clay, gritty	13'	73'
Clay, chocolate	7'	80'
Cement Gravel	3'	83'
Gravel and Sand	6'	89'
Harder Gravel	15'	104'
Clay, mixed color	11'	115'
Gravel, some loose	34'	149'
Clay	2'	151'
Gravel	21'	172'



Township 6 S Range R. 1 W, W.M.  
North

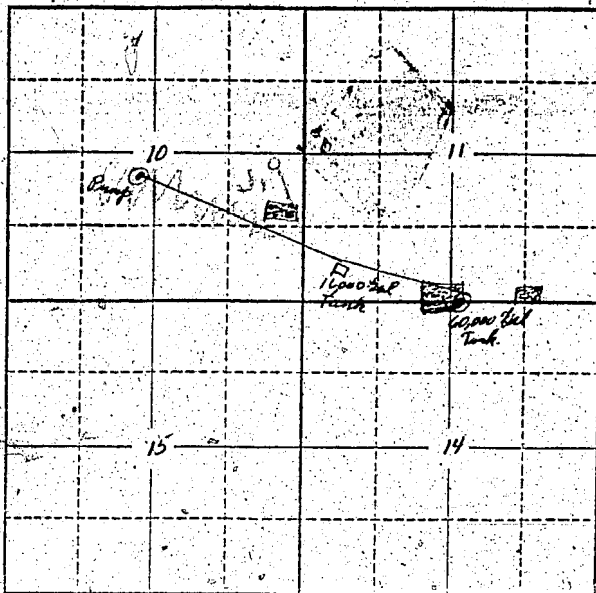

Locate well and acreage of irrigated land on plat.

Scale: 2" = 1 Mile

STATE OF OREGON

County of Marion } ss.

I, Hilary Grantz, being first duly sworn, do hereby certify that I have read the foregoing Registration Statement and that all of the items therein contained are true to the best of my knowledge and belief.

*M.A. Angel Libbey*  
*Hilary Grantz*  
(Signature of Registrant)

Subscribed and sworn to before me this 23rd day of January, 19 56

My commission expires Aug. 9, 1960

*Joseph A. ...*  
(Notary Public)

(SEAL)

**CERTIFICATE OF REGISTRATION**

STATE OF OREGON

County of Marion } ss.

This is to certify that the foregoing Registration Statement was received in the office of the State Engineer on the 24th day of February, 1956, at 4:30 o'clock P.M. and has been duly recorded in said office in Book No. 1 of Registration Statements on page GR-116C

~~Construction has been completed by ... and the water completely applied to beneficial use by ...~~

Witness my hand this 12th day of April, 19 56

*Laura A. Stanley*  
(State Engineer)

By \_\_\_\_\_  
(Deputy)