

Registration No. GR - 1251

Certificate No. GR - 1320

Registration Statement

OF CLAIMANT OF RIGHT TO APPROPRIATE GROUND WATER

TO THE STATE ENGINEER OF OREGON:

I, Roger R. & Laura B. Giles

of 219 West 1st. Street, Gresham
(Mailing address)

County of Multnomah

State of Oregon, do hereby make application for a certificate of registration as evidence of a right to appropriate ground water.

1. Source from which water is withdrawn is Pump Well
(Flowing well, pump well, infiltration trench, or tunnel)

2. Location is: on West 1st street in the city of Gresham, Oregon
(Approximate distance and direction from nearest city or town)

and is more particularly described as follows:

90 feet west and 2130 ft. south of the NE Corner of Section 9, T.1 S., R. 3 E.

(a) SE 1/4 Sec. 9
(Give distance and bearing to corner of section or other legal subdivision)

being within SE 1/4 Sec. 9 of Sec. 9 Twp. 1 S. Rge. 3 E.
(Smallest legal subdivision) (N. or S.) (E. or W.)

And (b) within limits of recorded platted property, town or city: of Gresham, Oregon

in Lot 11 Block Metzger Addition
(Name of plat or addition)

Gresham, Oregon County of Multnomah
(If within city or town, give name)

3. Construction Work was begun on 1940, was completed on 1943
(Date) (Date)

and the ground water claimed was first used for the purposes set out below on June 1943
(Date)

since which time the water has been used during the summer only
(Continuously or intermittently)

from April 1 to October 1 of each year.
(Date) (Date)

4. Quantity of water claimed and used is 12 gallons per minute; acre feet per year.

5. Purpose or Purposes for which water is used Irrigation on 2.01 acres.

(Domestic, irrigation, municipal, manufacturing, industrial, etc.)

6. Description of Well: Depth 15 feet. Type Dug and hand drilled
(Dug or drilled)

diameter 10 inches. Elevation of ground at well site 507 feet, mean sea level.
(As near as known)

Depth to water table 1 feet.

7. Capacity of Well: 12 g.p.m. with 0.5 feet drawdown.

g.p.m. with feet drawdown.

Date of test Never tested.

If Flowing Well: Measured discharge g.p.m. on
(Date)

Shut-in pressure at ground surface lbs. per sq. in. on
(Date)

Water is controlled by (Cap, valve, etc.)

size.)

10"	inch diameter	from surface	to 0	feet
14	inch diameter	from 0.2 feet	to 15	feet
	inch diameter	from	to	feet
	inch diameter	from	to	feet

Describe and show depth of shoe, plug, adapter, liner or other details: metal casing

9. Perforated Casings or Screens:

perforated with $\frac{1}{4}$ inch holes every 4 inches all ways from 11 to 15 ft.
(Number per foot and size of perforations, or describe screen)

from to


..... from to

..... from to

10. **Log of Well:** (Describe each stratum or formation clearly, indicate if water bearing, and give thickness and depth as indicated.)

[illegible]

Township 1 S. Range 3 E. W.M.
North

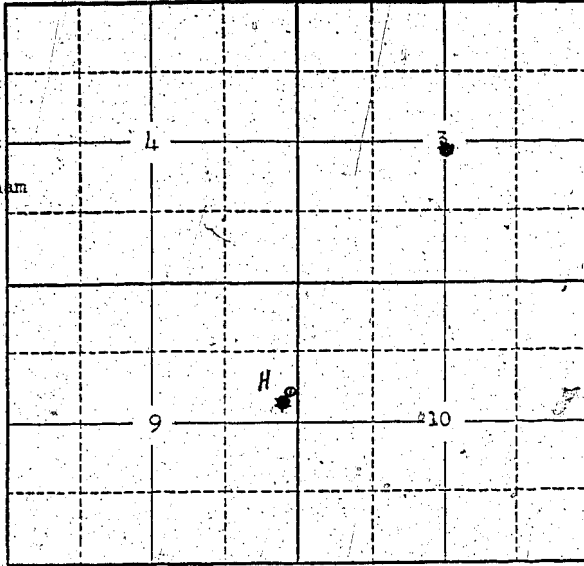

Note: See attached plat
copied off the plat
of the city of Gresham
for Tax Lot # 11.

Locate well and acreage of irrigated land on plat.

Scale: 2" = 1 Mile

STATE OF OREGON

County of Multnomah

ss.

I, _____, being first duly sworn, do hereby certify that I have
read the foregoing Registration Statement and that all of the items therein contained are true to the best of
my knowledge and belief.

Roger H. H.
(Signature of Registrant)

Subscribed and sworn to before me this 24 day of March, 1958.

My commission expires Commission Expires April 24, 1964

(Notary Public)

(SEAL)

CERTIFICATE OF REGISTRATION

STATE OF OREGON

County of Marion

ss.

This is to certify that the foregoing Registration Statement was received in the office of the State
Engineer on the 25th day of March, 1958, at 8:00 o'clock A.M. and has been
duly recorded in said office in Book No. 6 of Registration Statements on page GR-1320

Witness my hand this 20th day of October, 1958

Lewis A. Stanley
(State Engineer)

By _____

(Deputy)

GR - 1320