

Registration Statement

OF CLAIMANT OF RIGHT TO APPROPRIATE GROUND WATER

TO THE STATE ENGINEER OF OREGON:

I, Norman Hubert Florence Hubert

of Rt 1 Box 430 Madras County of Marian

State of Oregon, do hereby make application for a certificate of registration as evidence of a right to appropriate ground water.

1. Source from which water is withdrawn is Pump Well
(Flowing well, pump well, infiltration trench, or tunnel)

2. Location is: Four miles west of Madras
(Approximate distance and direction from nearest city or town)

and is more particularly described as follows:

(a) 1400' S & 710' E from NW Corner Sect 20
(Give distance and bearing to corner of section or other legal subdivision)

being within SW 1/4 NW 1/4 of Sec. 20, Twp. 5 S Rge. 2 W
(Smallest legal subdivision) (N. or S.) (E. or W.)

or (b) within limits of recorded platted property, town or city:

in Lot _____, Block _____ of _____
(Name of plat or addition)

County of _____
(If within city or town, give name)

3. Construction Work was begun on March 1 1955, was completed on April 9 1955
(Date) (Date)

and the ground water claimed was first used for the purposes set out below on May 1 1955
(Date)

since which time the water has been used intermittently
(Continuously or intermittently)

from April to October
(Date) (Date)

X 4. Quantity of water claimed and used is 170 gallons per minute; 4.5 acre feet per year.

5. Purpose or Purposes for which water is used irrigation
(Domestic, irrigation, municipal, manufacturing, industrial, etc.)

6. Description of Well: Depth 116 feet. Type drilled
(Dug or drilled)

diameter 12 inches. Elevation of ground at well site 210 feet, mean sea level.
(As near as known)

Depth to water table 12 feet.

7. Capacity of Well: 300 g.p.m. with 3.5 feet drawdown.

475 g.p.m. with 4.7 feet drawdown.


Date of test April 9 1955

If Flowing Well: Measured discharge _____ g.p.m. on _____
(Date)

Shut-in pressure at ground surface _____ lbs. per sq. in. on _____
(Date)

Water is controlled by _____
(Cap, valve, etc.)

Township 5S Range 2W, W.M.
North

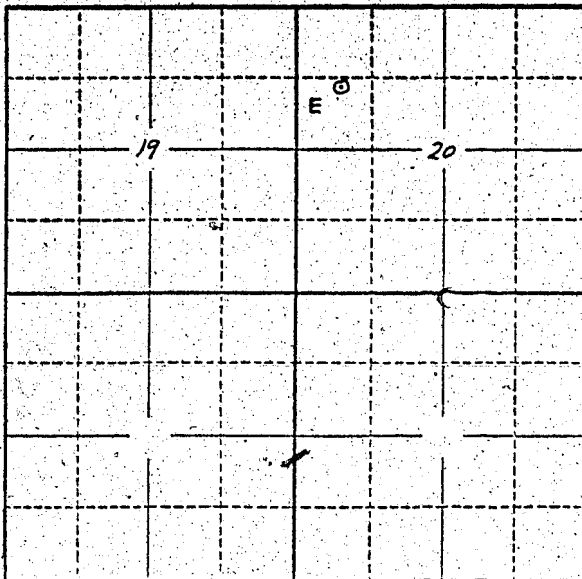

Locate well and acreage of irrigated land on plat.
Scale: 2" = 1 Mile

STATE OF OREGON

County of _____ } ss.

I, NORMAN NIBLER, being first duly sworn, do hereby certify that I have read the foregoing Registration Statement and that all of the items therein contained are true to the best of my knowledge and belief.

Norman Nibler
(Signature of Registrant)

Subscribed and sworn to before me this 25 day of March, 1958.

My commission expires 9/27/58

Jeanie Baxter
(Notary Public)

(SEAL)

CERTIFICATE OF REGISTRATION

STATE OF OREGON

County of Marion } ss.

This is to certify that the foregoing Registration Statement was received in the office of the State Engineer on the 25 day of March, 1958, at 3:55 o'clock P. M. and has been duly recorded in said office in Book No. 6 of Registration Statements on page GR-1215

Witness my hand this 19 day of September, 1958

Lewis A. Stanley
(State Engineer)

By _____
(Deputy)

GR - 1215