

RECEIVED

MAR 26 1958
STATE ENGINEER
SALEM, OREGON

Registration Statement

Registration No. GR-1260

Certificate No. GR-1216

OF CLAIMANT OF RIGHT TO APPROPRIATE GROUND WATER

TO THE STATE ENGINEER OF OREGON:

I, W.A. & Goldie M. Stephenson

of Jefferson County of Morion

State of Oregon, do hereby make application for a certificate of registration as evidence of a right to appropriate ground water.

1. Source from which water is withdrawn is Pump Well
(Flowing well, pump well, infiltration trench, or tunnel)

2. Location is: 3/4 mile South of Jefferson
(Approximate distance and direction from nearest city or town)

and is more particularly described as follows:

(a) 390' South 480' West NE corner Sec 14 T10S R3W
(Give distance and bearing to corner of section or other legal subdivision)

being within NE 1/4 of NE 1/4 of Sec. 14, Twp. 10.5, Rge. 3 W
(Smallest legal subdivision) (N. or S.) (E. or W.)

or (b) within limits of recorded platted property, town or city:

in Lot _____, Block _____ of _____
(Name of plat or addition)

County of _____
(If within city or town, give name)

3. Construction Work was begun on Don't know; was completed on 1940
(Date) (Date)

and the ground water claimed was first used for the purposes set out below on 1940
(Date)

since which time the water has been used intermittently
(Continuously or intermittently)

from April to October
(Date) (Date)

4. Quantity of water claimed and used is 200 gallons per minute; 22.5 acre feet per year.

5. Purpose or Purposes for which water is used irrigation

(Domestic, irrigation, municipal, manufacturing, industrial, etc.)

6. Description of Well: Depth 26 feet. Type Drilled
(Dug or drilled)

diameter 8 inches. Elevation of ground at well site 205 feet, mean sea level.
(As near as known)

Depth to water table 19 feet.

7. Capacity of Well: Don't know g.p.m. with _____ feet drawdown.

_____ g.p.m. with _____ feet drawdown.


Date of test _____

If Flowing Well: Measured discharge _____ g.p.m. on _____
(Date)

Shut-in pressure at ground surface _____, lbs. per sq. in. on _____
(Date)

Water is controlled by _____
(Cap, valve, etc.)

Township 10 S Range 3 W W.M.
North

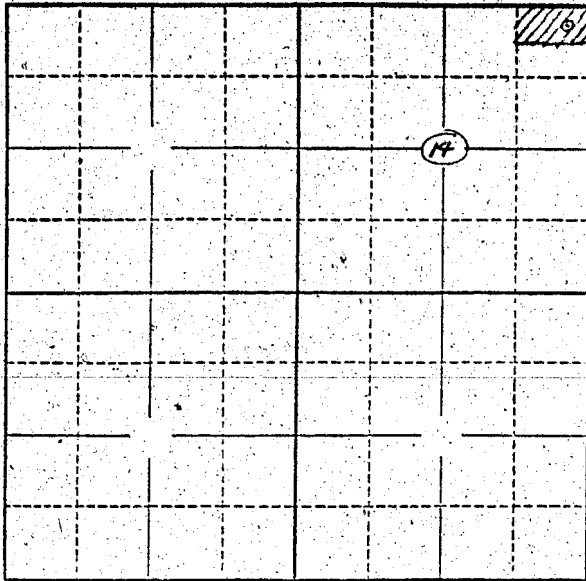

Locate well and acreage of irrigated land on plat.
Scale: 2" = 1 Mile

STATE OF OREGON

County of Linn } ss.

W.A. and Goldie M. Stephenson, being first duly sworn, do hereby certify that I have read the foregoing Registration Statement and that all of the items therein contained are true to the best of my knowledge and belief.

W.A. Stephenson Goldie M. Stephenson
(Signature of Registrant)

Subscribed and sworn to before me this 13th day of March 1958

My commission expires Charles W. Council
(Notary Public)

(SEAL)

NOTARY PUBLIC FOR OREGON
My Commission Expires October 25, 1961

CERTIFICATE OF REGISTRATION

STATE OF OREGON }
County of Marion } ss.

This is to certify that the foregoing Registration Statement was received in the office of the State Engineer on the 26th day of March, 1958, at 10¹⁰ o'clock A.M. and has been duly recorded in said office in Book No. 6 of Registration Statements on page GR-1216

Witness my hand this 19 day of September, 1958

\$15.00

Lewis A. Stanley
(State Engineer)

By _____
(Deputy)

GR - 1216