

Registration No. GR - 1261

Certificate No. GR - 1217

# Registration Statement

## OF CLAIMANT OF RIGHT TO APPROPRIATE GROUND WATER

TO THE STATE ENGINEER OF OREGON:

I, Harold J. Davis, Kath I. Davis, Fred and Dorothy Brougher

of 4999 River Road, Junction City County of Lane

State of Oregon, do hereby make application for a certificate of registration as evidence of a right to appropriate ground water.

1. Source from which water is withdrawn is pump well  
(Flowing well, pump well, infiltration trench, or tunnel)

2. Location is: five miles south of Junction City  
(Approximate distance and direction from nearest city or town)

and is more particularly described as follows:

(a) 1 chain S 19 chains west from the N E corner of section 27  
(Give distance and bearing to corner of section or other legal subdivision)

being within N E 1/4 N E 1/4 of Sec. 27, Twp. 16 S, Rge. 4 West  
(Smallest legal subdivision) (N. or S.) (E. or W.)

or (b) within limits of recorded platted property, town or city:

in Lot \_\_\_\_\_ Block \_\_\_\_\_ of \_\_\_\_\_  
(Name of plat or addition)

County of \_\_\_\_\_  
(If within city or town, give name)

3. Construction Work was begun on April 10, 1955; was completed on April 15, 1955  
(Date) (Date)

and the ground water claimed was first used for the purposes set out below on May 1955  
(Date)

since which time the water has been used intermittently  
(Continuously or Intermittently)

from May 1955 to October 1955  
(Date) (Date)

4. Quantity of water claimed and used is 300 gallons per minute; 75 acre feet per year.

5. Purpose or Purposes for which water is used irrigation of vegetables  
beets and sweet corn  
(Domestic, irrigation, municipal, manufacturing, industrial, etc.)

6. Description of Well: Depth 26 feet. Type driven  
(Dug or drilled)

diameter 4 inch inches. Elevation of ground at well site \_\_\_\_\_ feet, mean sea level.  
(As near as known)

Depth to water table 10 feet.

7. Capacity of Well: 325 g.p.m. with 15 feet drawdown.

\_\_\_\_\_ g.p.m. with \_\_\_\_\_ feet drawdown:

Date of test No test

If Flowing Well: Measured discharge \_\_\_\_\_ g.p.m. on \_\_\_\_\_  
(Date)


Shut-in pressure at ground surface \_\_\_\_\_ lbs. per sq. in. on \_\_\_\_\_  
(Date)

Water is controlled by \_\_\_\_\_  
(Cap, valve, etc.)





Township 11 S Range 4 W, W.M.  
North

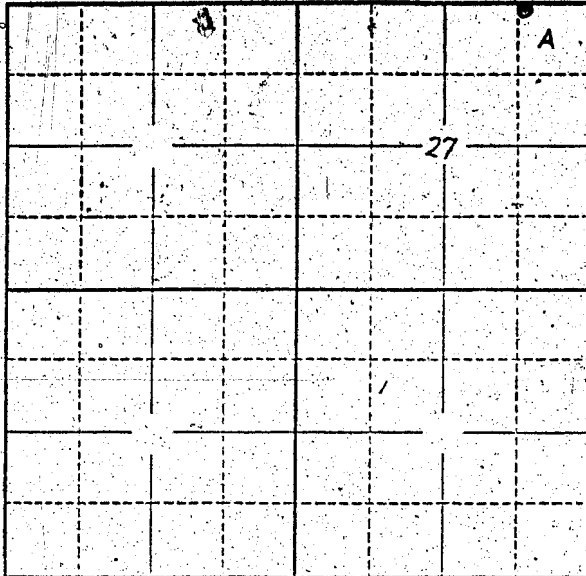

Locate well and acreage of irrigated land on plat.  
Scale: 2" = 1 Mile

STATE OF OREGON

County of Lane

ss.

I, Harold J. Davis, being first duly sworn, do hereby certify that I have read the foregoing Registration Statement and that all of the items therein contained are true to the best of my knowledge and belief.

Harold J. Davis  
(Signature of Registrant)

Subscribed and sworn to before me this 24<sup>th</sup> day of March, 1958.

My commission expires Nov 25 1958

Walter J. Brown  
(Notary Public)

(SEAL)

**CERTIFICATE OF REGISTRATION**

STATE OF OREGON

County of Marion

ss.

This is to certify that the foregoing Registration Statement was received in the office of the State Engineer on the 26<sup>th</sup> day of March, 1958, at 8:00 o'clock A.M. and has been duly recorded in said office in Book No. 6 of Registration Statements on page GR-1217

Witness my hand this 19 day of September, 1958

\$15.00

Laura A. Stanley  
(State Engineer)

By \_\_\_\_\_  
(Deputy)

GR - 1217