

RECEIVED
MAR 24 1955
STATE ENGINEER
SALEM, OREGON

Registration No. GR - 1262

Certificate No. GR - 1218

Registration Statement

OF CLAIMANT OF RIGHT TO APPROPRIATE GROUND WATER

TO THE STATE ENGINEER OF OREGON:

18 acres

I, Fred Broncher do file for Clarence and Hazel pond, one-half Clarence pond, one-half
of 5265 River Road, Junction City Trustee
(Mailing address) County of Lane

State of Oregon, do hereby make application for a certificate of registration as evidence of a right to appropriate ground water.

1. Source from which water is withdrawn is pump well #2
(Flowing well, pump well, infiltration trench, or tunnel)

2. Location is: five miles south of Junction City on River Road
(Approximate distance and direction from nearest city or town)

and is more particularly described as follows:

(a) 21 chains North, 17 chains west of South East Corner of section 22
(Give distance and bearing to corner of section or other legal subdivision)

being within North East 1/4 S. E. 1 of Sec. 22, Twp. 16 S., Rge. 4 East
(Smallest legal subdivision) (N. or S.) (E. or W.)

or (b) within limits of recorded platted property, town or city:

in Lot _____, Block _____
(Name of plat or addition)

County of _____
(If within city or town, give name)

3. Construction Work was begun on April 15, 1955; was completed on April 20, 1955
(Date) (Date)

and the ground water claimed was first used for the purposes set out below on May 15, 1955
(Date)

since which time the water has been used intermittently
(Continuously or intermittently)

from May 15, 1955 to October 1, 1955
(Date) (Date)

4. Quantity of water claimed and used is 300 gallons per minute; 0 acre feet per year.

5. Purpose or Purposes for which water is used irrigation of ve. etables, beans, corn

on 18 acres
(Domestic, irrigation, municipal, manufacturing, industrial, etc.)

6. Description of Well: Depth 25 feet. Type driven well
(Dug or drilled)

diameter 4 inches. Elevation of ground at well site 344 feet, mean sea level.
(As near as known)

Depth to water table 12 feet.

7. Capacity of Well: 325 g.p.m. with 14 feet drawdown.

_____ g.p.m. with _____ feet drawdown.


Date of test May 10, 1955

If Flowing Well: Measured discharge 225 g.p.m. on May 10, 1955
(Date)

Shut-in pressure at ground surface _____ lbs. per sq. in. on _____
(Date)

Water is controlled by _____
(Cap. valve, etc.)

Township 16.5 Range 4W W.M.
North

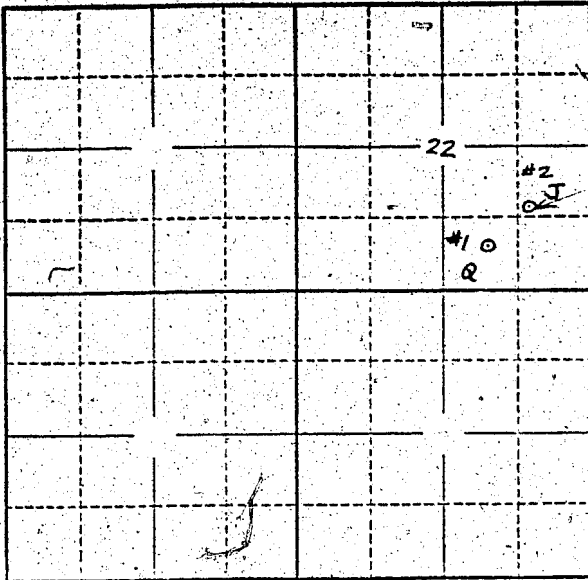

Locate well and acreage of irrigated land on plat.
Scale: 2" = 1 Mile

STATE OF OREGON

County of Lane } ss.

I, Fred Braughler, being first duly sworn, do hereby certify that I have read the foregoing Registration Statement and that all of the items therein contained are true to the best of my knowledge and belief.

Fred Braughler
(Signature of Registrant)

Subscribed and sworn to before me this 24th day of March, 1958

My commission expires June 25, 1961

Walter T. Hanson
(Notary Public)

(SEAL)

CERTIFICATE OF REGISTRATION

STATE OF OREGON

County of Marion } ss.

This is to certify that the foregoing Registration Statement was received in the office of the State Engineer on the 26th day of March, 1958, at 5:00 o'clock A. M. and has been duly recorded in said office in Book No. 6 of Registration Statements on page GR-1218

Witness my hand this 19 day of September, 1958

Lewis A. Stanley
(State Engineer)

By _____

(Deputy)

GR-1218