RECEIVED
MAR 1 1954
STATE ENGINEER
SALEM, OREGON

Registration No. GR - 1263

Certificate No. GR - 1219

Registration Statement

OF CLAIMANT OF RIGHT TO APPROPRIATE GROUND WATER

20 acres

TO THE STATE ENGINEER OF OREGON:

I, Fred Brougher do file for Clarence and Hazel Bond .one-half Clarence Bond one-half trustee

of 6265 River Road, Junction City (Mailing address) County of Lane

State of Oregon, do hereby make application for a certificate of registration as evidence of a right to appropriate ground water.

1. **Source** from which water is withdrawn is pump well (Flowing well, pump well, infiltration trench, or tunnel)

2. **Location** is: Five miles south of Junction City, Oregon (Approximate distance and direction from nearest city or town);

and is more particularly described as follows:

(a) 12 chains North, 27 chains West, from South East corner of Section 22 (Give distance and bearing to corner of section or other legal subdivision)

being within S. W. 1/4 S. E. 1/4 (Smallest legal subdivision) of Sec. 22, Twp. 16 South (N. or S.), Rge. 4 West (E. or W.)

or (b) within limits of recorded platted property, town or city:

in Lot ....., Block ..... of ..... (Name of plat or addition)

..... (If within city or town, give name) County of .....

3. **Construction Work** was begun on March 10, 1954 (Date); was completed on March 15, 1954 (Date)

and the ground water claimed was first used for the purposes set out below on May 20, 1954 (Date),

since which time the water has been used intermittently. (Continuously or intermittently)

from May 20 (Date) to Sept (Date)

4. **Quantity** of water claimed and used is 300 gallons per minute; 50 acre feet per year.

5. **Purpose or Purposes** for which water is used irrigation of vegetable crops 20 acres under this one well (Domestic, irrigation, municipal, manufacturing, industrial, etc.)

6. **Description of Well:** Depth 32 feet. Type driven well (Dug or drilled)

diameter 4inch inches. Elevation of ground at well site 353 (As near as known) feet, mean sea level.

Depth to water table 12 feet.

7. **Capacity of Well:** 325 g.p.m. with 0 feet drawdown.

..... g.p.m. with ..... feet drawdown.

Date of test March 20, 1954

If Flowing Well: Measured discharge ..... g.p.m. on ..... (Date)

Shut-in pressure at ground surface ..... lbs. per sq. in. on ..... (Date)

Water is controlled by ..... (Cap, valve, etc.)

6M—4-57

8. **Casing:** (Give diameter, commercial specifications and depth below ground surface of each casing size.)

4 inch diameter from 0 to 32 feet

inch diameter from to feet

inch diameter from to feet

inch diameter from to feet

Describe and show depth of shoe, plug, adapter, liner or other details:

9. **Perforated Casings or Screens:**

4 inch by 5 inch 12 slots from 27 feet to 32 feet
(Number per foot and size of perforations, or describe screen)

from to

from to

from to

10. **Log of Well:** (Describe each stratum or formation clearly, indicate if water bearing, and give thickness and depth as indicated.)

MATERIAL	Thickness (Feet)	Depth to Bottom (Feet)
Don't Know		

GR 1219

If log of well is not available, give name and address of driller. .....

.....

11. **Infiltration Trench:** Covered or open .....

Dimensions: Length ..... ft. Minimum depth ..... ft. Maximum depth ..... ft.

Bottom width ..... ft. Discharge ..... g.p.m. Date of test .....

12. **Tunnel:** Type of lining .....

Dimensions: .....
(Length, course, and cross sectional size)

Position of water bearing stratum with reference to portal of tunnel .....

.....

Log of tunnel: (Preceding table for log of well may be used, if desired. Give footage from portal and character of materials, as pertinent.)

13. **Pumping Equipment:**

(a) Pump Berkley .....
(Make, type and size)
Capacity 300 g.p.m.

(b) Motor 15 hosepower .....
(Type and horsepower)

14. Location of area irrigated or to be irrigated, or place of use if for purposes other than irrigation.

Township North or South	Range E. or W. of Willamette Meridian	Section	Forty-acre Tract	Number Acres To Be Irrigated	Date of Reclamation
T16S	R4W	22	N.W. ¼ of S. E. ¼	2.5	May 1954
"	"	22	N.E. ¼ of S. E. ¼	.03	" "
"	"	22	S. W. ¼ of SE ¼	13.00	" "
"	"	22	S. E. ¼ of S E ¼	4.2	" "
				19.73	

15. If the ground water supply is supplemental to an existing water supply, identification of any application for a permit, permit, certificate or adjudicated right to appropriate water made or held by the registrant.

.....

.....

Township 16 S Range 4W, W.M.

North

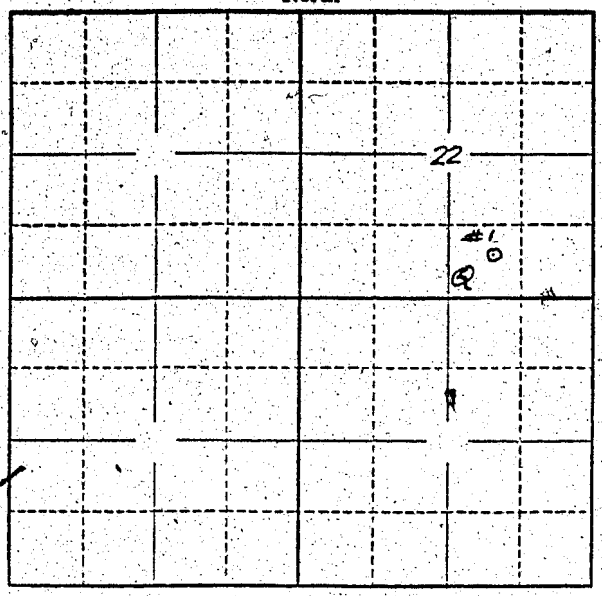

Locate well and acreage of irrigated land on plat.

Scale: 2" — 1 Mile

STATE OF OREGON
County of Lane } ss.

I, FRED BROUGHER, being first duly sworn, do hereby certify that I have read the foregoing Registration Statement and that all of the items therein contained are true to the best of my knowledge and belief.

Fred Brougher
(Signature of Registrant)

Subscribed and sworn to before me this 24th day of March, 19 58

My commission expires June 25, 1961 Lilla J. Lane
(Notary Public)

(SEAL)

CERTIFICATE OF REGISTRATION

STATE OF OREGON
County of Marion } ss.

This is to certify that the foregoing Registration Statement was received in the office of the State Engineer on the 26th day of March, 19 58, at 2:00 o'clock P. M. and has been duly recorded in said office in Book No. 6 of Registration Statements on page GR-1219

Witness my hand this 19 day of September, 19 58

Lewis A. Stanley
(State Engineer)

By
(Deputy)

GR - 1219