

RECEIVED  
MAR 20 1953  
STATE ENGINEER  
SALEM, OREGON

Registration No. GR - 1264  
Certificate No. GR - 1220

# Registration Statement

## OF CLAIMANT OF RIGHT TO APPROPRIATE GROUND WATER

TO THE STATE ENGINEER OF OREGON:

I, Harold G. and George R. Seifert

of Rt 2 Box 459, Eugene County of Lane

(Mailing address)

State of Oregon, do hereby make application for a certificate of registration as evidence of a right to appropriate ground water.

1. Source from which water is withdrawn is Pump well # 2  
(Flowing well, pump well, infiltration trench, or tunnel)

2. Location is: 3 miles N. W. Of Soburg, Oregon  
(Approximate distance and direction from nearest city or town)

and is more particularly described as follows:

(a) N 690' W 2820' from SE corner of the NE 1/4 of Sec 24  
(Give distance and bearing to corner of section or other legal subdivision)

being within SE 1/4 NW 1/4 of Sec. 24, Twp. 16 S, Rge. 4 W  
(Smallest legal subdivision) (N. or S.) (E. or W.)

or (b) within limits of recorded platted property, town or city:

in Lot \_\_\_\_\_, Block \_\_\_\_\_ of \_\_\_\_\_  
(Name of plat or addition)

(If within city or town, give name)

County of \_\_\_\_\_

3. Construction Work was begun on May 1952; was completed on May 1952  
(Date) (Date)

and the ground water claimed was first used for the purposes set out below on May 1952  
(Date)

since which time the water has been used intermittently  
(Continuously or Intermittently)

from April to October  
(Date) (Date)

4. Quantity of water claimed and used is 425 gallons per minute; 74 acre feet per year.

5. Purpose or Purposes for which water is used Irrigation

(Domestic, irrigation, municipal, manufacturing, industrial, etc.)

6. Description of Well: Depth 20 feet. Type Driven  
(Dug or drilled)

diameter 6 inches. Elevation of ground at well site 360 plus or minus feet, mean sea level.  
(As near as known)

Depth to water table 10 feet, approximately

7. Capacity of Well: \_\_\_\_\_ g.p.m. with \_\_\_\_\_ feet drawdown.

\_\_\_\_\_ g.p.m. with \_\_\_\_\_ feet drawdown.

Date of test Not tested

If Flowing Well: Measured discharge \_\_\_\_\_ g.p.m. on \_\_\_\_\_  
(Date)

Shut-in pressure at ground surface \_\_\_\_\_ lbs. per sq. in. on \_\_\_\_\_  
(Date)


Water is controlled by \_\_\_\_\_  
(Cap, valve, etc.)





Well #2

Township 16 S Range 4 W, W.M.  
North

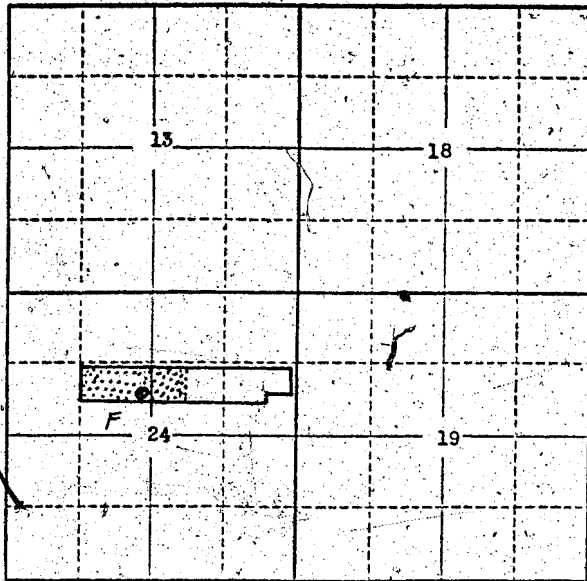

Locate well and acreage of irrigated land on plat.  
Scale: 2" = 1 Mile

STATE OF OREGON

County of Lane } ss.

Harold G. Seifert

I, George R. Seifert, being first duly sworn, do hereby certify that I have read the foregoing Registration Statement and that all of the items therein contained are true to the best of my knowledge and belief.

*Harold G. Seifert George R. Seifert*  
(Signature of Registrant)

Subscribed and sworn to before me this 24th day of March, 1958

My commission expires August 13, 1958

*Wm. D. [unclear]*  
(Notary Public)

(SEAL)

CERTIFICATE OF REGISTRATION

STATE OF OREGON

County of Marion } ss.

This is to certify that the foregoing Registration Statement was received in the office of the State Engineer on the 26th day of March, 1958, at 6:00 o'clock A.M. and has been duly recorded in said office in Book No. 6 of Registration Statements on page GR-1220

Witness my hand this 19 day of September, 1958

*Lewis A. Stanley*  
(State Engineer)

By \_\_\_\_\_ (Deputy)

GR-1220