


6-122

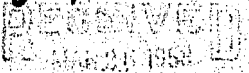

Registration No. GR - 1267

Certificate No. GR - 1223

STATE ENGINEER
SALMON, OREGON

Registration Statement

OF CLAIMANT OF RIGHT TO APPROPRIATE GROUND WATER

TO THE STATE ENGINEER OF OREGON:

I, Kenneth Oberson

of P.O. Box 165

(Mailing address)

County of Polk

State of Oregon, do hereby make application for a certificate of registration as evidence of a right to appropriate ground water.

Well #
1

1. Source from which water is withdrawn is Pump Well
(Flowing well, pump well, infiltration trench, or tunnel)

2. Location is: 1 Mile South West Independence Oregon
(Approximate distance and direction from nearest city or town)

and is more particularly described as follows:

(a) N 35° W 1800' FROM SE CORNER SEC 29
(Give distance and bearing to corner of section or other legal subdivision)

being within NE/SE of Sec. 29, Twp. 8S, Rge. 4W
(Smallest legal subdivision) (N. or S.) (E. or W.)

or (b) within limits of recorded platted property, town or city:

in Lot _____, Block _____ of _____
(Name of plat or addition)

County of _____
(If within city or town, give name)

3. Construction Work was begun on Sept 1, 1948; was completed on Sept 8, 1948
(Date) (Date)

and the ground water claimed was first used for the purposes set out below on 1949
(Date)

since which time the water has been used Continuously
(Continuously or intermittently)

from May 1949 to 1957
(Date) (Date)

4. Quantity of water claimed and used is 100 gallons per minute; 759 acre feet per year.

5. Purpose or Purposes for which water is used Irrigation

(Domestic, irrigation, municipal, manufacturing, industrial, etc.)

6. Description of Well: Depth 58 feet. Type Drilled
(Dug or drilled)

diameter 12 inches. Elevation of ground at well site Unknown feet, mean sea level.
(As near as known)

Depth to water table 20ft feet.

7. Capacity of Well: 100 g.p.m. with 38 feet drawdown.

_____ g.p.m. with _____ feet drawdown.


Date of test _____

If Flowing Well: Measured discharge _____ g.p.m. on _____
(Date)

Shut-in pressure at ground surface _____ lbs. per sq. in. on _____
(Date)

Water is controlled by _____
(Cap, valve, etc.)

Township 85 Range 40 W.M.
North

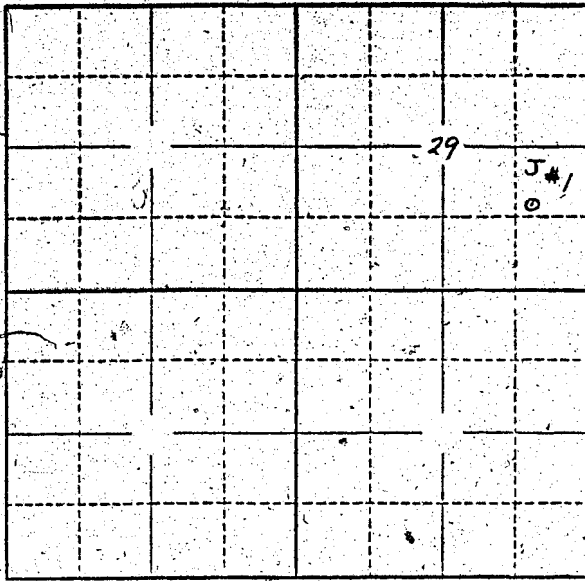

Locate well and acreage of irrigated land on plat.
Scale: 2" = 1 Mile

STATE OF OREGON }
County of Marion } ss.

I, _____, being first duly sworn, do hereby certify that I have read the foregoing Registration Statement and that all of the items therein contained are true to the best of my knowledge and belief.

Kenneth O'Brien
(Signature of Registrant)

Subscribed and sworn to before me this 25th day of March, 1958.

My commission expires 12th June 1961

Wm. S. Bradford
(Notary Public)

(SEAL)

CERTIFICATE OF REGISTRATION

STATE OF OREGON }
County of Marion } ss.

This is to certify that the foregoing Registration Statement was received in the office of the State Engineer on the 26th day of March, 1958, at 8:00 o'clock A. M. and has been duly recorded in said office in Book No. 6 of Registration Statements on page GR-1223

Witness my hand this 19 day of September, 1958

Leura A. Stanley
(State Engineer)

By _____
(Deputy)